IREDELL COUNTY HEALTH DEPARTMENT

STATESVILLE 704-878-5305 MOORESVILLE 704-664-5281

(C1)

IMPROVEMENT PERMIT / AUTHORIZATION TO CONSTRUCT / OPERATION PERMIT / EXISTING SYSTEM INSPECTION

PERMIT# 151549 PIN# 4726-96-5040 DATE 9-5-2008

OWNER OR APPLICANT LIBERTY BAPTIST CHURCH PHONE: Business Home 704-880-5779

ADDRESS 137 PULPWOOD LANE, STATESVILLE, NC 28625

LOCATION NC 115 NORTH, ON RIGHT AT BOX # 137

SUBDIVISION BLOCK / SECTION LOT LOT AREA 7.33 ACRES SITE CLASS. PS DESIGN FLOW 375 L.T.A.R. 0.30 GPD/FT²

Septic Tank: 1000 Gallons; STB Date

Pump Tank: Gallons; PT Date

Pump Make: Model Serial No.

Nitrification Field: No Fields 1 Square Feet 1250 Linear Feet 416'

No Lines 3 Trench Width 3 Max Trench Bottom Depth 24" Gravel Depth 12" ☒ Gravity ☐ Pressure

☐ New System ☐ Repair ☐ Expansion System Type: I II III IV V VI

System Description: CONVENTIONAL GRAVITY

Repair System Description: CONVENTIONAL GRAVITY

Maintenance Agreement Required: ☐ Yes ☒ No

☐ House/Mod. Home ☐ Mobile Home ☐ Business ☒ Other CHURCH

No. Bedrooms No. Persons 125 No. Employees w/ 125


Water Supply: ☐ Individual ☒ Public ☐ Community

☒ Slab ☐ Crawl Space ☐ Basement w/plumbing ☐ Basement wo/plumbing


Comments:/Conditions:

Comments:/Conditions: SYSTEM SIZED FOR MAXIMUM 125 SEATING CAPACITY

INITIAL SITE SKETCH

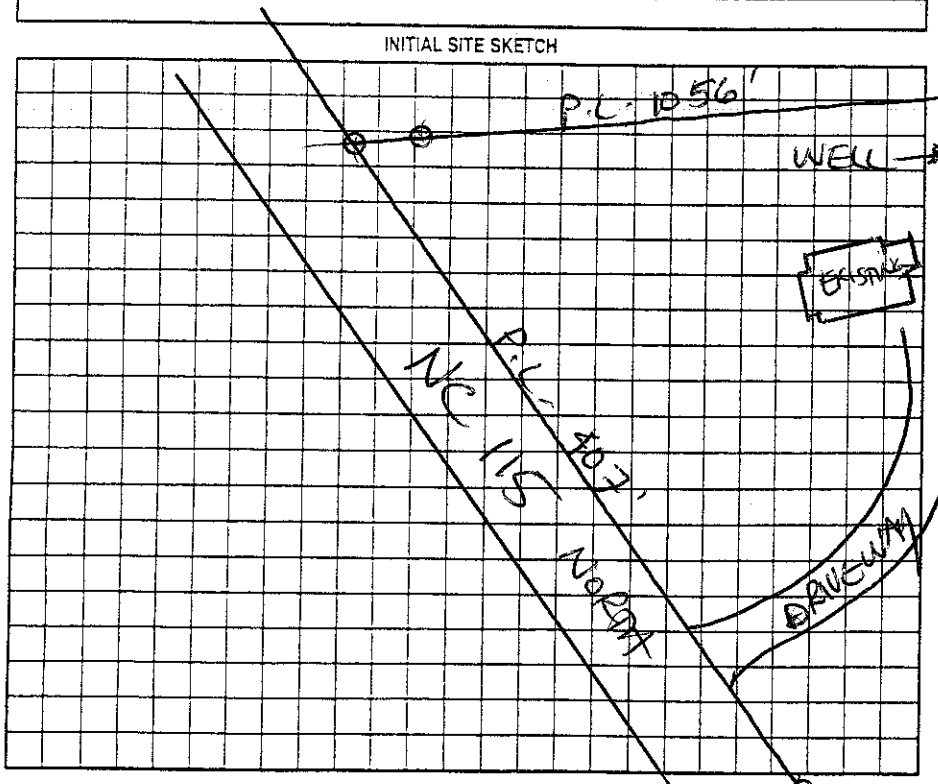

AS BUILT SKETCH

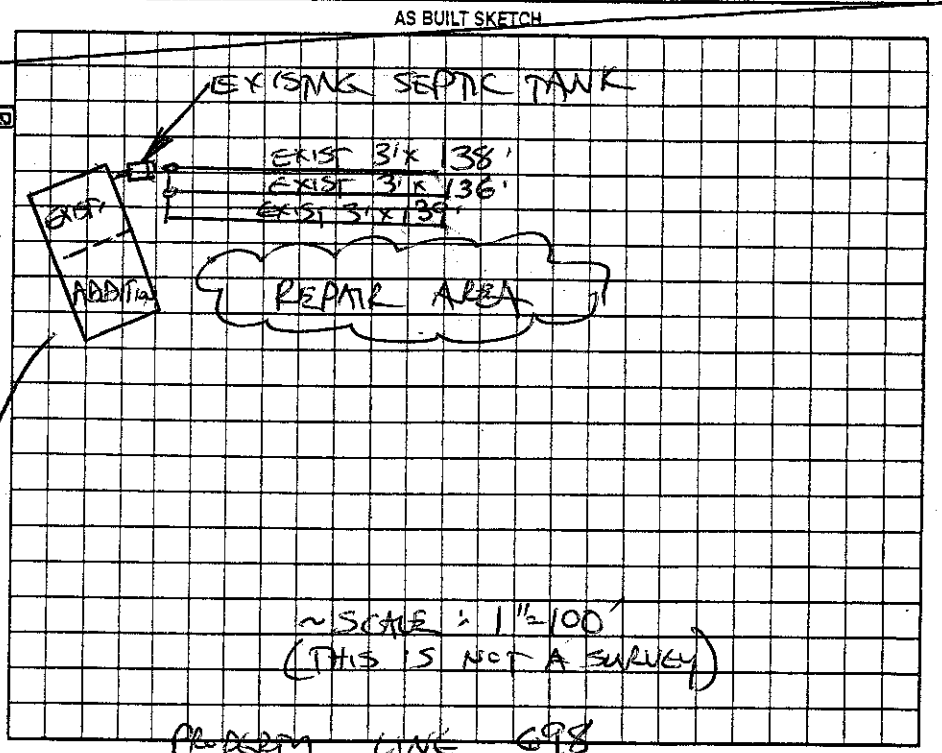

Permit can be suspended or revoked if any false information is supplied toward securing the permit, any unauthorized changes are made to the site/any unauthorized changes are made in the installation of the system. Improvement Permit with plat valid without expiration ☐ Improvement Permit with site plan valid for sixty months ☐ Authorization to Construct is valid for a period equal to that of Improvement Permit – not to exceed sixty months.

Signed: date

Improvement Permit by: date

Authorization to Construct by: date

Installed by:

Operation Permit by: date

Existing System Inspection by: STEVE HEDRICK date 9-5-2008

HEALTH DEPT. COPY: WHITE OWNER COPY (FINAL): YELLOW OWNER COPY (INITIAL): PINK