IREDELL COUNTY HEALTH DEPARTMENT

STATESVILLE 704-878-5305 MOORESVILLE 704-664-5281

IMPROVEMENT PERMIT / AUTHORIZATION TO CONSTRUCT / OPERATION PERMIT / EXISTING SYSTEM INSPECTION

PERMIT# 094036 PIN# 4726 96 5040 DATE 2/1/01

OWNER OR CONTRACTOR LIBERTY BAPTIST CHURCH PHONE: Business (704) 539-4675 Home

ADDRESS 137 PULPWOOD LANE, STATESVILLE, NC 28677

LOCATION HWY 115 N, @ PULPWOOD LN. TO END

SUBDIVISION BLOCK / SECTION LOT LOT AREA 7.33 Ac. SITE CLASS PS DESIGN FLOW 375 GPD L.T.A.R. .30

Septic Tank: 1000 Gallons: STB 1012 Date 12-10-2001

Pump Tank: Gallons: PT Date

Pump Make: Model Serial No

Nitrification Field: No Fields 1 Square Feet 1250 Linear Feet 416'

No Lines 3 Trench Width 3' Max Trench Bottom Depth 24" Gravel Depth 12"

☑ New System ☐ Repair System Type: I (II) III, IV, V, VI

System Description: CONVENTIONAL

Repair System Description: SAME

Maintenance Agreement Required: ☐ Yes ☐ No

☐ House/Mod. Home No. Bedrooms

☐ Mobile Home No. Bathrooms

☐ Business No. Employees

☑ Other CHURCH FELLOWSHIP HALL


☑ Slab ☐ Crawl Space ☐ Basement w/plumbing ☐ Basement w/o plumbing

Water Supply: ☐ Individual ☑ Public ☐ Community


Comments/Conditions: ① NO CUTTING OR FELLING OVER DRAINFIELD/REPAIR AREAS ② KEEP ALL DRAINS AWAY FROM DRAINFIELD/REPAIR AREAS ③ MAINTAIN NOTED SETBACKS ④ INSTALL SYSTEM UNIFORM AND ON CONTOUR ⑤ PUMP EXISTING TANK AND CRUSH/FILL IN PLACE.

Comments/Conditions: - Poly Lok Filter Installed - Septic Tank Risers Installed

INITIAL SITE SKETCH

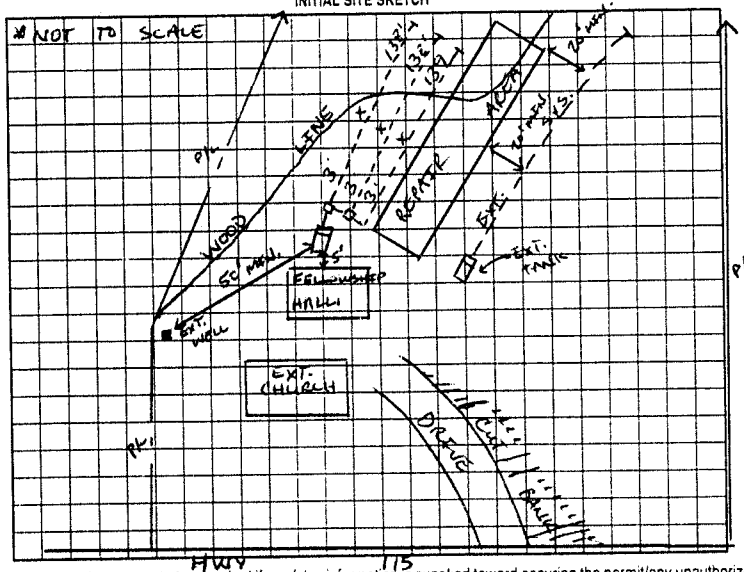

AS BUILT SKETCH

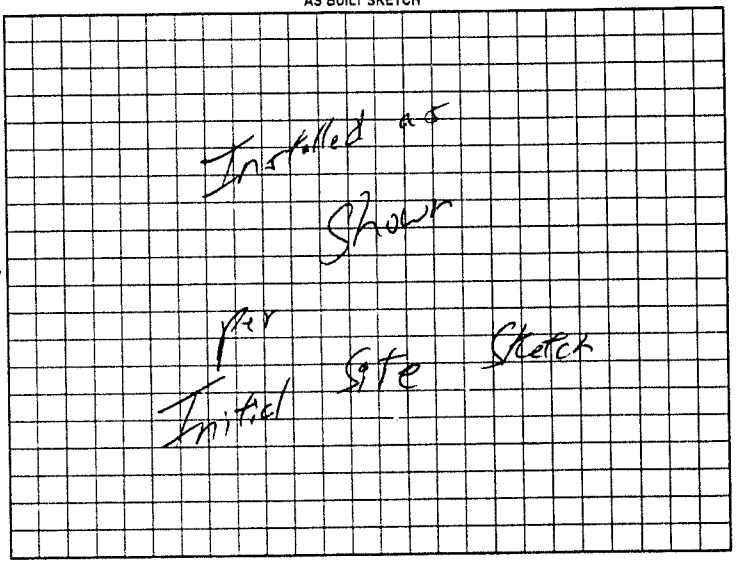

Permit can be suspended or revoked if any false information is supplied toward securing the permit/any unauthorized changes are made to the site/any unauthorized changes are made in the installation of the system. Improvement Permit with plat valid without expiration. Improvement Permit with site plan valid for sixty months. Authorization to Construct is valid for a period equal to that of Improvement Permit – not to exceed sixty months.

Signed: Lynnette Mackenzie date 2/2/01

Improvement Permit by: Susan Shinn date 2/1/01

Authorization to Construct by: Susan Shinn date 2/1/01

Installed by: Forrest Shuford

Operation Permit by: William O. Johnson RSI date 5-16-01

Existing System Inspection by: date

HEALTH DEPT COPY WHITE OWNER COPY (FINAL) YELLOW OWNER COPY (INITIAL) PINK