IREDELL COUNTY HEALTH DEPARTMENT

STATESVILLE 704-878-5305 MOORESVILLE 704-664-5281 CI

IMPROVEMENT PERMIT / AUTHORIZATION TO CONSTRUCT / OPERATION PERMIT / EXISTING SYSTEM INSPECTION

PERMIT# 122158 PIN# 4727-05-0786 DATE 6/30/04

OWNER OR CONTRACTOR David Comer PHONE: Business — Home (704) 880-3437

ADDRESS 320 Trinity Rd Statesville, N.C. 28625

LOCATION Hwy 115 N, (R) Coachman Loop, (L) Trinity Road 1st driveway to left past Potts Grant Lane (@320 Trinity Rd)

SUBDIVISION — BLOCK / SECTION — LOT — LOT AREA 20.24 AC SITE CLASS. PS DESIGN FLOW 360 L.T.A.R. Ex

Septic Tank: 1,000 Gallons; STB Ex Date

Pump Tank: — Gallons; PT — Date

Pump Make: — Model — Serial No.

Nitrification Field: No Fields 1 Square Feet 720 Linear Feet 240

No Lines 2 Trench Width — Max Trench Bottom Depth — Gravel Depth 12"

☒ ~~New~~/System ☐ Repair System Type: I, II, III, IV, V, VI

System Description: Gravity, Conventional

Repair System Description:

Maintenance Agreement Required: ☐ Yes ☒ No

☒ House/Mod. Home No. Bedrooms 3

☐ Mobile Home No. Bathrooms 2

☐ Business No. Employees

☐ Other

☐ Slab ☐ Crawl Space ☒ Basement w/plumbing ☒ Basement wo/plumbing


Water Supply: ☒ Individual ☐ Public ☐ Community

Comments:/Conditions:

Comments:/Conditions: ① Existing System Not in use at time of Inspection, System appears to be working properly. (Reference: David Comer - 8/29/84)

INITIAL SITE SKETCH

AS BUILT SKETCH

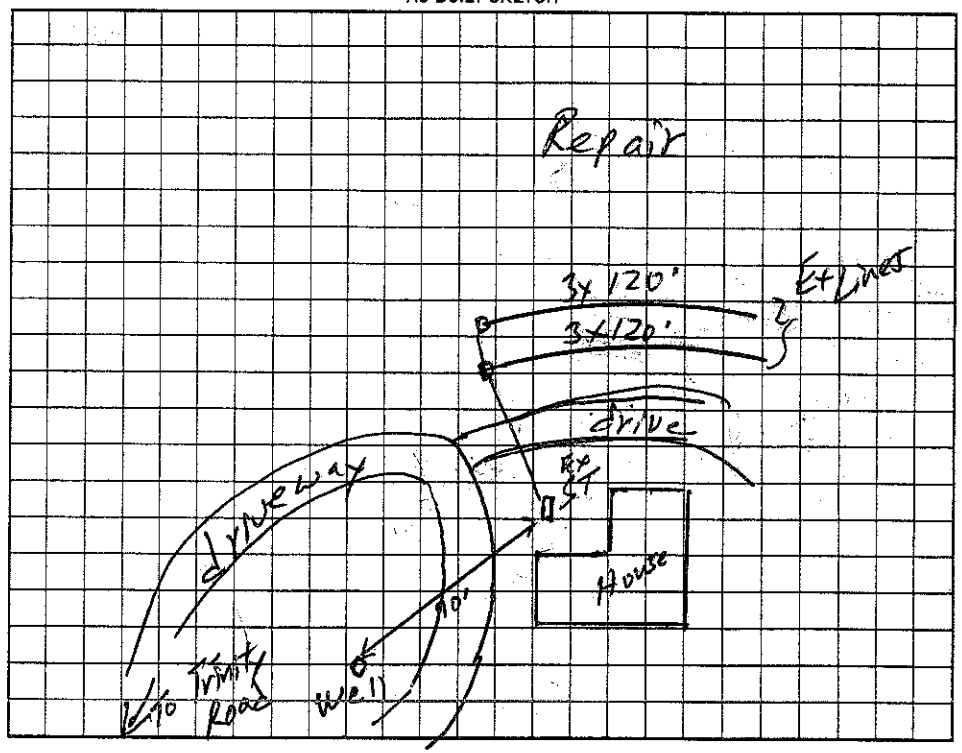

Permit can be suspended or revoked if any false information is supplied toward securing the permit/any unauthorized changes are made to the site/any unauthorized changes are made in the installation of the system. Improvement Permit with plat valid without expiration. Improvement Permit with site plan valid for sixty months. Authorization to Construct is valid for a period equal to that of Improvement Permit – not to exceed sixty months.

Signed: [signature] date 6/30/04 Installed by:

Improvement Permit by: date Operation Permit by: date

Authorization to Construct by: date Existing System Inspection by: William O. Johnson date 6/30/04

HEALTH DEPT. COPY: WHITE OWNER COPY (FINAL): YELLOW OWNER COPY (INITIAL): PINK