IREDELL COUNTY HEALTH DEPARTMENT

STATESVILLE 704-878-5305 CI MOORESVILLE 704-664-5281

IMPROVEMENT PERMIT / AUTHORIZATION TO CONSTRUCT / OPERATION PERMIT / EXISTING SYSTEM INSPECTION

PERMIT# 11254 PIN# ~~4919-99-9465~~ 4727-99-5089 DATE 5/14/03

OWNER OR CONTRACTOR Dennis Hutchins PHONE: Business (704) 883-0198 Home

ADDRESS 214 / 018 Intr. Road Statesville, NC. 28625

LOCATION Hwy 115 N, @ midway, @ Cove Gap Rd. @ Eagles Refuge, stay to Right past two bottlenecks to top of hill

SUBDIVISION — BLOCK / SECTION — LOT — LOT AREA 1.20 ± Ac SITE CLASS. PS DESIGN FLOW 480 L.T.A.R. .35

Septic Tank: 1000 Gallons; STB 1007 Date 1-26-04
Pump Tank: — Gallons; PT — Date —
Pump Make: — Model — Serial No. —
Nitrification Field: No Fields 1 Square Feet Eqv 1392 Linear Feet 345
No Lines 3 Trench Width 36" Max Trench Bottom Depth 36" Gravel Depth NA

☒ New System ☐ Repair System Type: I, II, III, IV, V, VI
System Description: Gravity, 25% Reduction
Repair System Description: Pump, 25% Reduction
Maintenance Agreement Required: ☐ Yes ☒ No

☒ House/Mod. Home No. Bedrooms 4
☐ Mobile Home No. Bathrooms 4
☐ Business No. Employees —
☐ Other —
☐ Slab ☐ Crawl Space ☒ Basement w/plumbing ☐ Basement wo/plumbing


Water Supply: ☐ Individual ☐ Public ☐ Community

Comments:/Conditions: ① Install liner on contour ② maintain proper setbacks.

not to scale

Comments:/Conditions:
- Tuff-Tite filter + ST marker Installed.
- Installed 55 Infiltrator Chambers

INITIAL SITE SKETCH

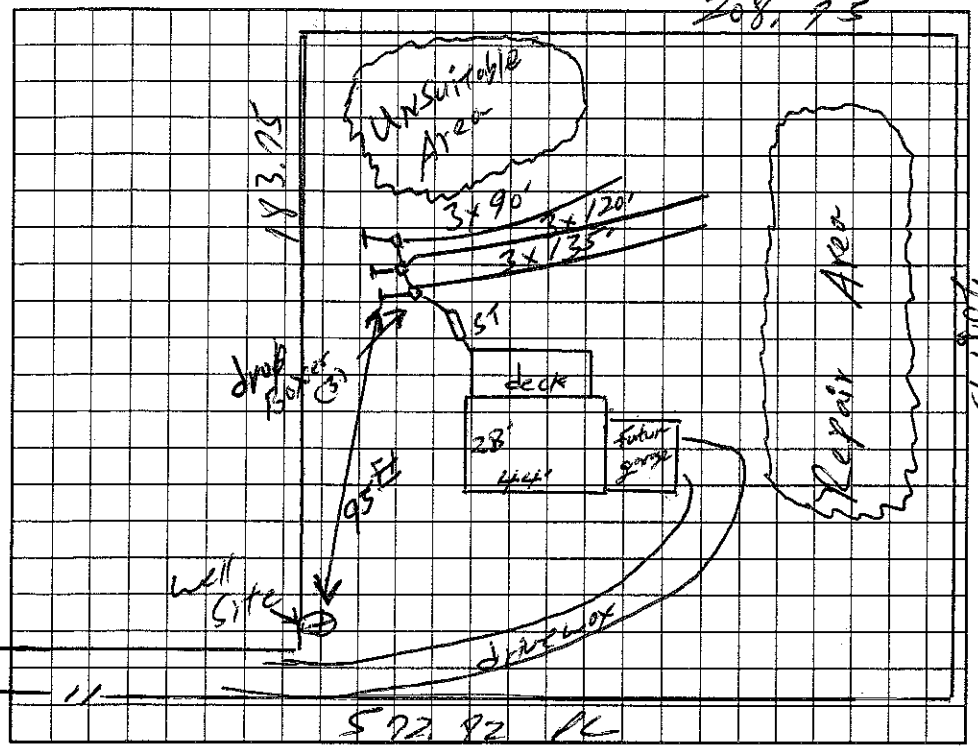

AS BUILT SKETCH

Installed as Shown per Initial Site Sketch

Permit can be suspended or revoked if any false information is supplied toward securing the permit/any unauthorized changes are made to the site/any unauthorized changes are made in the installation of the system. Improvement Permit with plat valid without expiration. Improvement Permit with site plan valid for sixty months. Authorization to Construct is valid for a period equal to that of Improvement Permit – not to exceed sixty months.

Signed: Dennis Hutchins date — Installed by: T. Cothern + Son

Improvement Permit by: William O. Johnson date 5/14/03 Operation Permit by: William O. Johnson date 3/17/04

Authorization to Construct by: William O. Johnson date 5/14/03 Existing System Inspection by: — date —

HEALTH DEPT. COPY: WHITE OWNER COPY (FINAL): YELLOW OWNER COPY (INITIAL): PINK