This Permits voids # 106053

IREDELL COUNTY HEALTH DEPARTMENT

STATESVILLE 704-878-5305 MOORESVILLE 704-664-5281

IMPROVEMENT PERMIT / AUTHORIZATION TO CONSTRUCT / OPERATION PERMIT / EXISTING SYSTEM INSPECTION

PERMIT# 13126A PIN# 4727-14-6892 DATE 6-22-06

OWNER OR APPLICANT Habitat For Humanity PHONE: Business 704 880 3068 Home

ADDRESS Potts Grant Lane

LOCATION NC115N (L) Coachman Loop (L) Trinity Rd. (R) Potts Grant Lane 2nd lot on Lft

SUBDIVISION Midway Park BLOCK / SECTION LOT 3 LOT AREA .54 Acre SITE CLASS. PS DESIGN FLOW ~~600~~ 480 L.T.A.R. .30

Septic Tank: 1000 Gallons; STB 760 Date 3-14-06
Pump Tank: Gallons; PT Date
Pump Make: Model Serial No.
Nitrification Field: No Fields 1 Square Feet 1200 Linear Feet 400
No Lines 4 Trench Width 36" Max Trench Bottom Depth 36" Gravel Depth n/a

☒ New System ☐ Repair ☐ Expansion System Type: I (II) III IV V VI
System Description: 25% Reduction Gravity
Repair System Description: 50% Reduction
Maintenance Agreement Required: ☐ Yes ☒ No

☒ House/Mod. Home ☐ Mobile Home ☐ Business ☐ Other
No. Bedrooms 4 No. Persons No. Employees


Water Supply: ☒ Individual ☐ Public ☐ Community

☒ Gravity ☐ Pressure ☐ Slab ☒ Crawl Space ☐ Basement w/plumbing ☐ Basement wo/plumbing


Comments:/Conditions:

Comments:/Conditions:
Red Fill
no risers no S/T marker

INITIAL SITE SKETCH

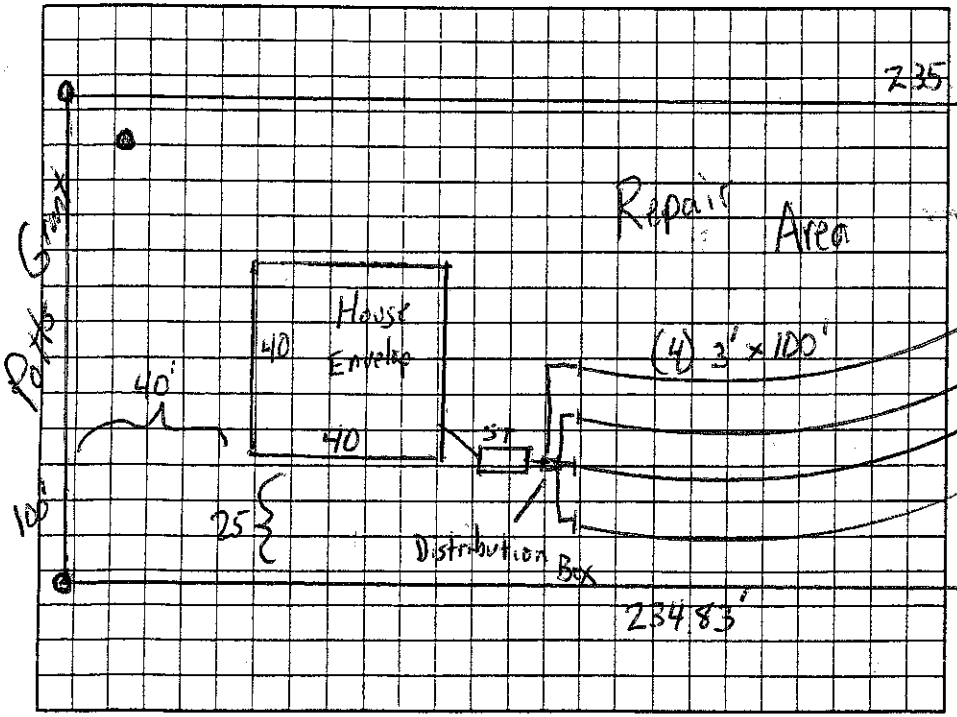

AS BUILT SKETCH

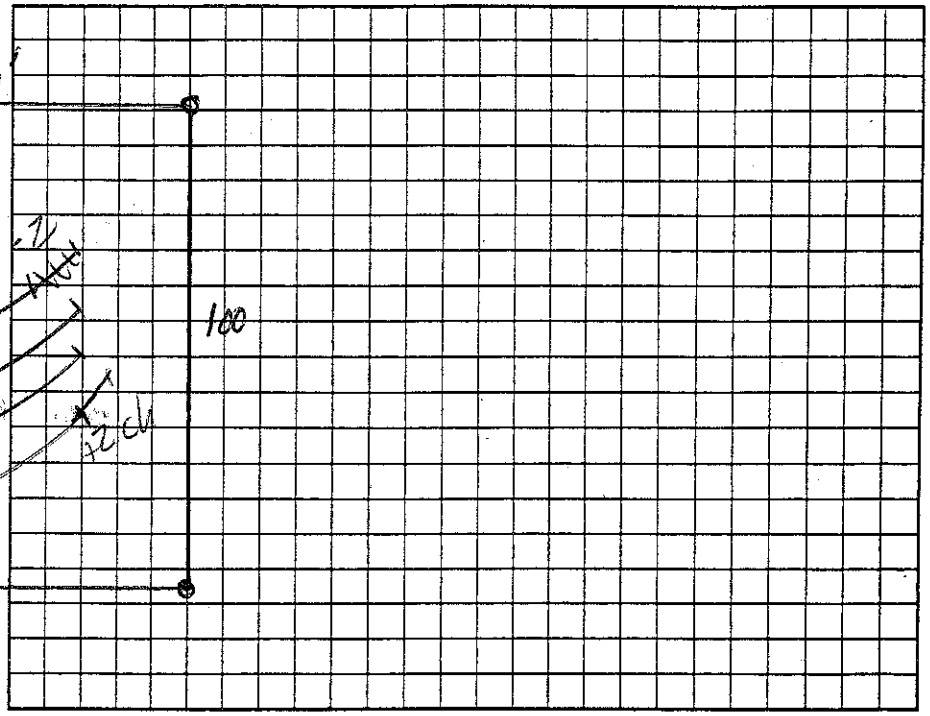

Permit can be suspended or revoked if any false information is supplied toward securing the permit/any unauthorized changes are made to the site/any unauthorized changes are made in the installation of the system. Improvement Permit with plat valid without expiration ☐ Improvement Permit with site plan valid for sixty months ☐ Authorization to Construct is valid for a period equal to that of Improvement Permit – not to exceed sixty months.

Signed: [signature] date 6-26-06
Improvement Permit by: [signature] date 6-22-06
Authorization to Construct by: [signature] date 6-22-06

Installed by: Brent Galliher
Operation Permit by: [signature] date 6-29-06
Existing System Inspection by: date

HEALTH DEPT. COPY: WHITE OWNER COPY (FINAL): YELLOW OWNER COPY (INITIAL): PINK