IREDELL COUNTY HEALTH DEPARTMENT

Statesville Office (704) 878-5305 Mooresville Office (704) 660-3625 PERMIT # 22/022

IMPROVEMENT PERMIT / AUTHORIZATION TO CONSTRUCT / OPERATION PERMIT / EXISTING SYSTEM

PIN # 4727149741

APPLICANT: Grace Cunningham APPLICANT ADDRESS: 303 N. Center St Statesville NC

SITE ADDRESS: 296 Trinity Rd. Statesville NC PHONE: 704-929-5726 ALT. PHONE: (513) 243-7892

SITE DIRECTIONS: 115 N T/C Coachmans Lp T/C Trinity Rd Lot on right


SUBDIVISION: Midway Park SECTION: N/A LOT # 20 LOT AREA: 0.459ac DESIGN FLOW: Ex L.T.A.R.: Ex

Septic Tank	1000	(gal)	STB	760	Date	1-8-16	☐ New System	☒ Repair	☐ Expansion	System Type: I	II	III IV V VI	☒ Residence	No. Bedrooms Ex
Pump Tank	N/A	(gal)	PT	N/A	Date	N/A	System Description:	Tank					☐ Business	No. Persons Ex
Pump Make	N/A	Model	Polylok		Serial #	PL-68	Repair System Description:						☐ Other	No. Employees
# Nitrification Fields	Ex	# Lines	Ex		Linear Ft:	Ex	Maintenance Agreement Required:	☐ YES	☒ NO				☒ Slab	☐ Crawl Space
Trench Width	Ex	Max. Trench Bottom Depth	Ex		Gravel Depth	Ex		☑ GRAVITY	☐ PRESSURE				☐ Basement w/plumbing	☐ Basement w/o plumbing

Water Supply: ☒ Private ☐ Public ☐ Community

Comments / Conditions: Pump, crush + fill existing tank maintain 5' off any building foundation 50' off any well and 10' off any property line.

INITIAL SITE SKETCH

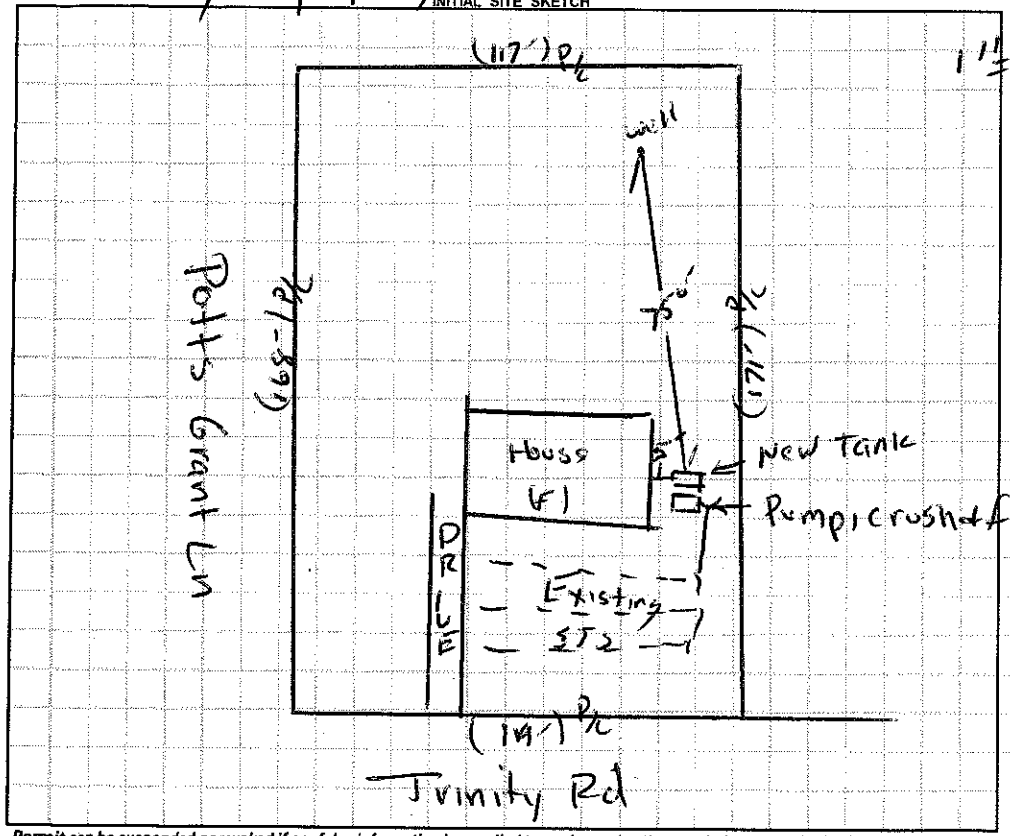

AS BUILT SKETCH

1" = 50'

Installed as drawn

Permit can be suspended or revoked if any false information is supplied toward securing the permit / any unauthorized changes are made to the site / any unauthorized changes are made in the installation of the system. **CONTACT A LOCATOR SERVICE PRIOR TO ANY EXCAVATION**

☐ **IMPROVEMENT PERMIT** *with plat* valid without expiration. ☒ **IMPROVEMENT PERMIT** *with site plan* valid for 60 mos. ☒ **AUTHORIZATION TO CONSTRUCT** valid for period equal to IMPROVEMENT PERMIT--not to exceed 60 mo.

Owner / Applicant Signature: Grace Cunningham Date: 8/23/16 Installed by: Lentz Wastewater

IMPROVEMENT PERMIT by: Date: 08/22/16 OPERATION PERMIT by: Date: 08/24/16

AUTHORIZATION TO CONSTRUCT by: Date: 08/22/16 Existing System Inspected by: Date:

Health Dept. Copy - WHITE Applicant (Final Approval) - YELLOW Applicant (Conditional Approval) - PINK