IREDELL COUNTY HEALTH DEPARTMENT

STATESVILLE 704-878-5305 (CI) MOORESVILLE 704-664-5281

(2) IMPROVEMENT PERMIT / AUTHORIZATION TO CONSTRUCT / OPERATION PERMIT / EXISTING SYSTEM INSPECTION

PERMIT# 140679 PIN# 4727-14-9885 DATE 6-12-07

OWNER OR APPLICANT HABITAT FOR HUMANITY of IREDELL Co. PHONE: Business 704-880-3068 Home

ADDRESS 1382-A SHELTON AVE, STATESVILLE, NC 28625

LOCATION NC 115 NORTH, TL COACHMAN'S LOOP TO TRINITY ROAD, TR POTTS GRANT LANE, 2ND LOT ON RIGHT

SUBDIVISION MIDWAY PARK BLOCK / SECTION LOT 19 LOT AREA 0.54 ACRE SITE CLASS. PS DESIGN FLOW 360 L.T.A.R. 0.30 GAD/FT

Septic Tank: 1000 Gallons; STB 760 Date 5-19-07

Pump Tank: Gallons; PT Date

Pump Make: Model EQ.TO Serial No.

Nitrification Field: No Fields 1 Square Feet 1200 Linear Feet 200

No Lines FOUR Trench Width 24" Max Trench Bottom Depth 36" Min Depth 24"

☑ New System ☐ Repair ☐ Expansion System Type: I II III IV V VI

System Description: 50% REDUCTION, GRAVITY

Repair System Description: 50% REDUCTION, PUMP

Maintenance Agreement Required: ☐ Yes ☑ No

☑ House/Mod. Home ☐ Mobile Home ☐ Business ☐ Other

No. Bedrooms 3 No. Persons No. Employees


Water Supply: ☑ Individual ☐ Public ☐ Community WELL

☑ Gravity ☐ Pressure ☐ Slab ☑ Crawl Space ☐ Basement w/plumbing ☐ Basement wo/plumbing


Comments/Conditions: ① IMPORTANT - STUB OUT PLUMBING AS HIGH AS FEASIBLE. ② INSTALL 50% REDUCTION SYSTEM ON CONTOUR AS SHOWN USING 48 PPBPS PANELS. ③ KEEP SYSTEM MAXIMUM FEASIBLE DISTANCE FROM WELLS (NO LESS THAN 50 FEET).

Comments/Conditions:

INITIAL SITE SKETCH

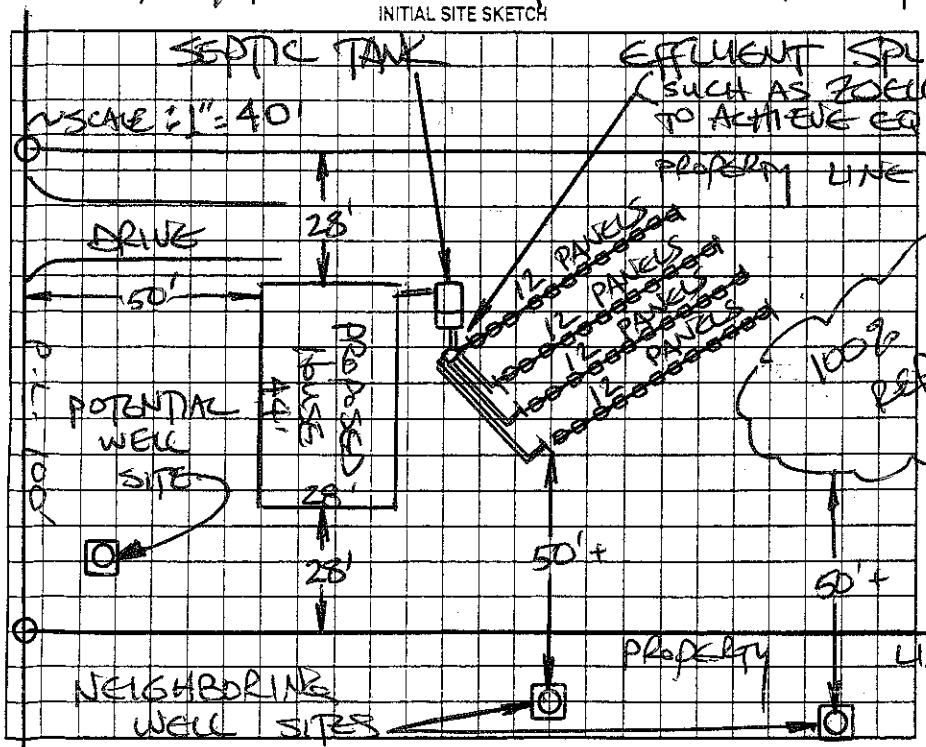

AS BUILT SKETCH

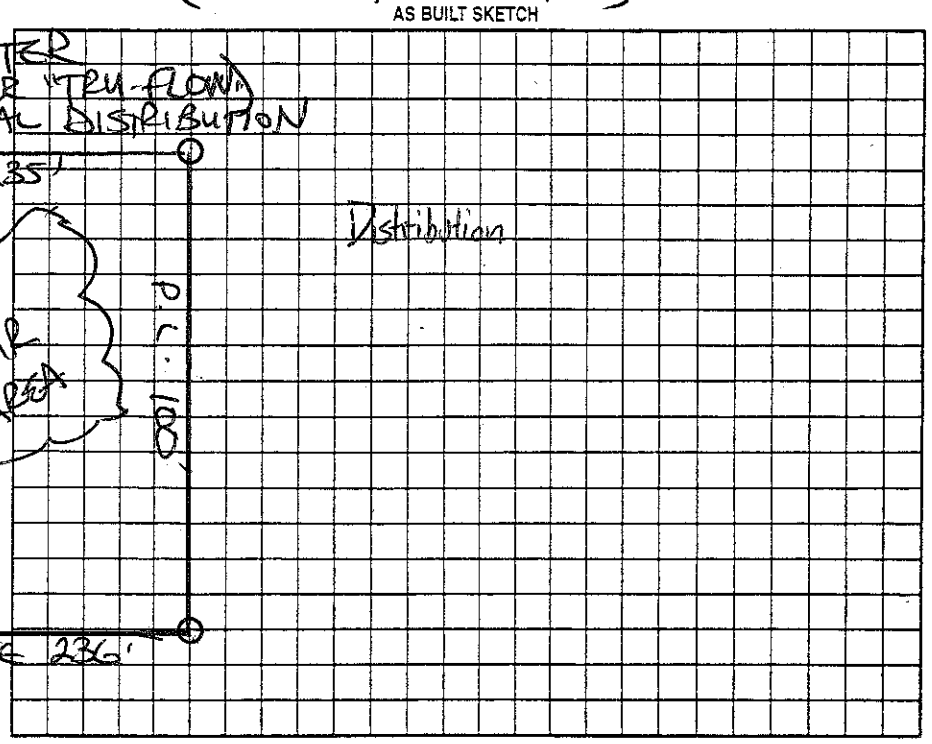

POTTS GRANT LANE

Permit can be suspended or revoked if any false information is supplied toward securing the permit/any unauthorized changes are made to the site/any unauthorized changes are made in the installation of the system. Improvement Permit with plat valid without expiration ☐ Improvement Permit with site plan valid for sixty months ☑ Authorization to Construct is valid for a period equal to that of Improvement Permit – not to exceed sixty months.

Signed: [signature] date 6-12-07

Improvement Permit by: STEVE HEDRICK date 6-12-07

Authorization to Construct by: STEVE HEDRICK date 6-12-07

Installed by: Callihan Grading

Operation Permit by: [signature] date 9-27-07

Existing System Inspection by: date

HEALTH DEPT. COPY: WHITE OWNER COPY (FINAL): YELLOW OWNER COPY (INITIAL): PINK