46666

IREDELL COUNTY HEALTH DEPARTMENT

STATESVILLE 704-878-5305 MOORESVILLE 704-664-5281

IMPROVEMENT PERMIT / CERTIFICATE OF COMPLETION / OPERATION PERMIT / EXISTING SYSTEM INSPECTION

PROPERTY DESCRIPTION NO. 15956 DATE 9/1/93 TAX MAP NO. 9M-1-A-18

OWNER OR CONTRACTOR LONNIE WELLMAN PHONE: Business Home 876-1808

ADDRESS

LOCATION NC 115 N TL COACHMAN LP, TL TRINITY RD, TR MIDWAY PARK DR, (PRIVATE). LOT # 18 ON (R)

SUBDIVISION MIDWAY PARK BLOCK / SECTION LOT 18 LOT AREA SITE CLASS. L.T.A.R. 0.33 GPD/FT²

Water Supply: ☑ Individual ☐ Community ☐ Public WELL

Septic Tank: 1000 Gallons; STB 1012 Date 6/2/93

Pump Tank: Gallons; PT Date

Nitrification Field: No Fields 1 Square Feet 300 Linear Feet 100

No Lines 2 Trench Width 36" Trench Depth 18-36 Gravel Depth 12"

☑ New System ☐ Repair System Type: I, II, III, IV, V, VI

System Description: CONV. GRAVITY

Repair System Description: CONV. GRAVITY

Maintenance Agreement Required: ☐ Yes ☑ No

☐ House/Mod. Home ☐ Mobile Home ☐ Business ☑ Other RESIDENTIAL GARAGE @ 100 GPD

No. Bedrooms No. Bathrooms No. Employees

Garbage Disposal: ☐ Yes ☑ No

Auto. Dishwasher: ☐ Yes ☑ No

Auto. Washing Machine: ☐ Yes ☑ No


Other

☑ Slab ☐ Crawl Space ☐ Basement w/plumbing ☐ Basement wo/plumbing

Comments

INITIAL SITE SKETCH

AS BUILT SKETCH

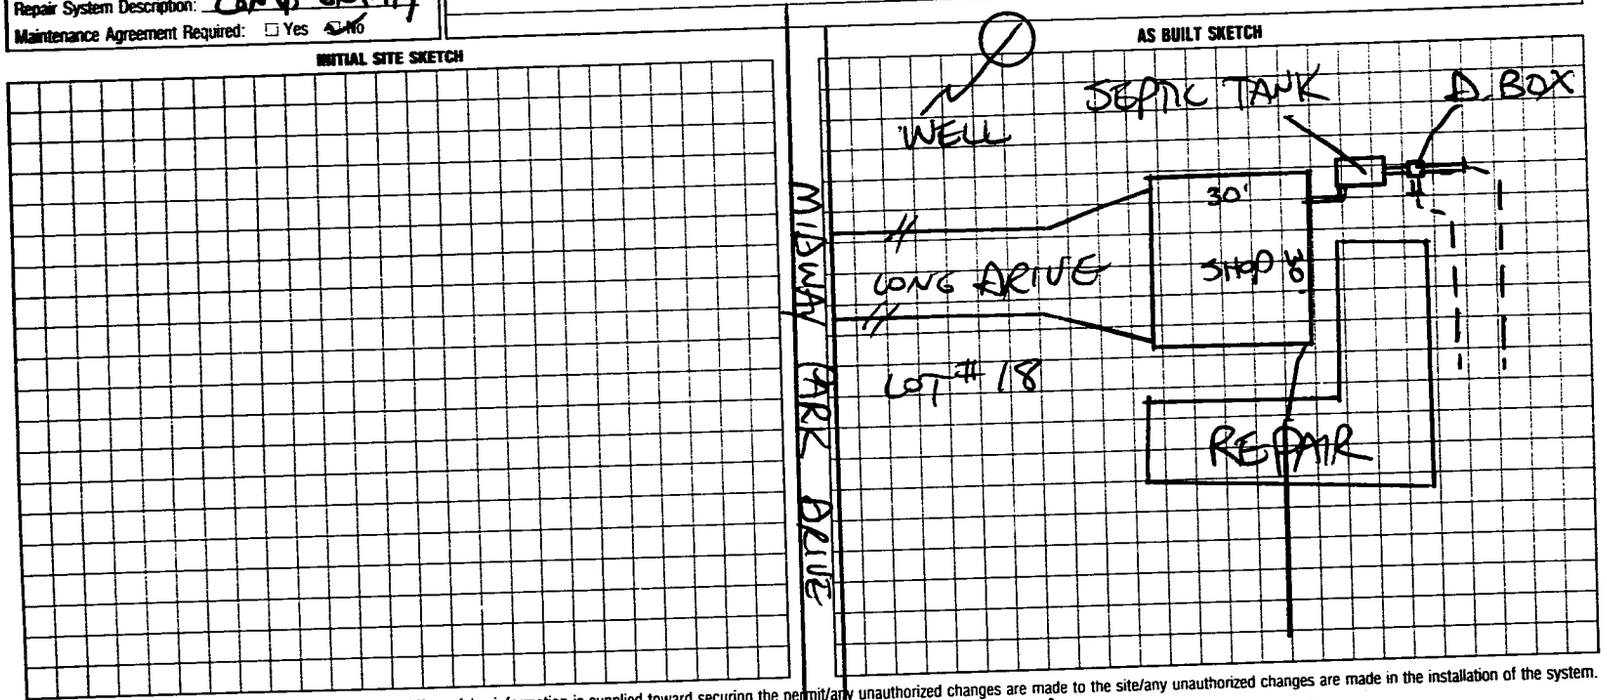

I understand that this permit can be suspended or revoked if any false information is supplied toward securing the permit/any unauthorized changes are made to the site/any unauthorized changes are made in the installation of the system. Improvement Permit is valid for 60 months from date of issuance.

Signed:

Improvement Permit by: STEVE HEDRICK date 3/24/93

Existing System Inspection by: date

Installed by: AAA ENTERPRISES

Certificate of Completion by: STEVE HEDRICK date 9/1/93

Operation Permit by: date

HEALTH DEPT. COPY: WHITE INSPECTION COPY (FINAL): GREEN OWNER COPY (FINAL): YELLOW INSPECTION COPY (INITIAL): PINK OWNER COPY (INITIAL): GOLD