THIS PERMIT VOIDS PREVIOUS ISSUED 5-26-00

IREDELL COUNTY HEALTH DEPARTMENT

STATESVILLE 704-878-5305 MOORESVILLE 704-664-5281

IMPROVEMENT PERMIT / AUTHORIZATION TO CONSTRUCT / OPERATION PERMIT / EXISTING SYSTEM INSPECTION

PERMIT# 105401 PIN# ~~105401~~ 4727-15-6122 DATE 4/19/02

OWNER OR CONTRACTOR Pilot Builders PHONE: Business (704) 202-4964 Home —

ADDRESS 450 Aurora Drive Statesville N.C. 28147

LOCATION 115 N. (L) Midway (R) Trinity (L) Potts Grant ON Left

SUBDIVISION Midway Park BLOCK / SECTION — LOT 6 LOT AREA .54 Ac. SITE CLASS PS DESIGN FLOW 360 L.T.A.R. .30

Septic Tank: 1,000 Gallons: STB 825 Date 2-21-02
Pump Tank: Gallons: PT Date
Pump Make: Model Serial No
Nitrification Field: No Fields 1 Square Feet equiv 1200 Linear Feet 300'
No Lines 5 @ 60' Trench Width 36" Max Trench Bottom Depth 30" Gravel Depth NA

[X] New System [ ] Repair System Type: I II (III) IV V VI
System Description: 25% Reduction, Gravity
Repair System Description: 50% Reduction Panel
Maintenance Agreement Required: [ ] Yes [ ] No
[X] Slab [ ] Crawl Space [ ] Basement w/plumbing [ ] Basement wo/plumbing


[X] House/Mod Home [ ] Mobile Home [ ] Business [ ] Other
No. Bedrooms 3 No. Bathrooms 2 No. Employees

Water Supply: [X] Individual [ ] Public [ ] Community


Comments/Conditions: (1) Do not install when wet (2) maintain proper setbacks (3) Keep System 100' from well(s).

Comments/Conditions: Poly lok Filter Installed

INITIAL SITE SKETCH

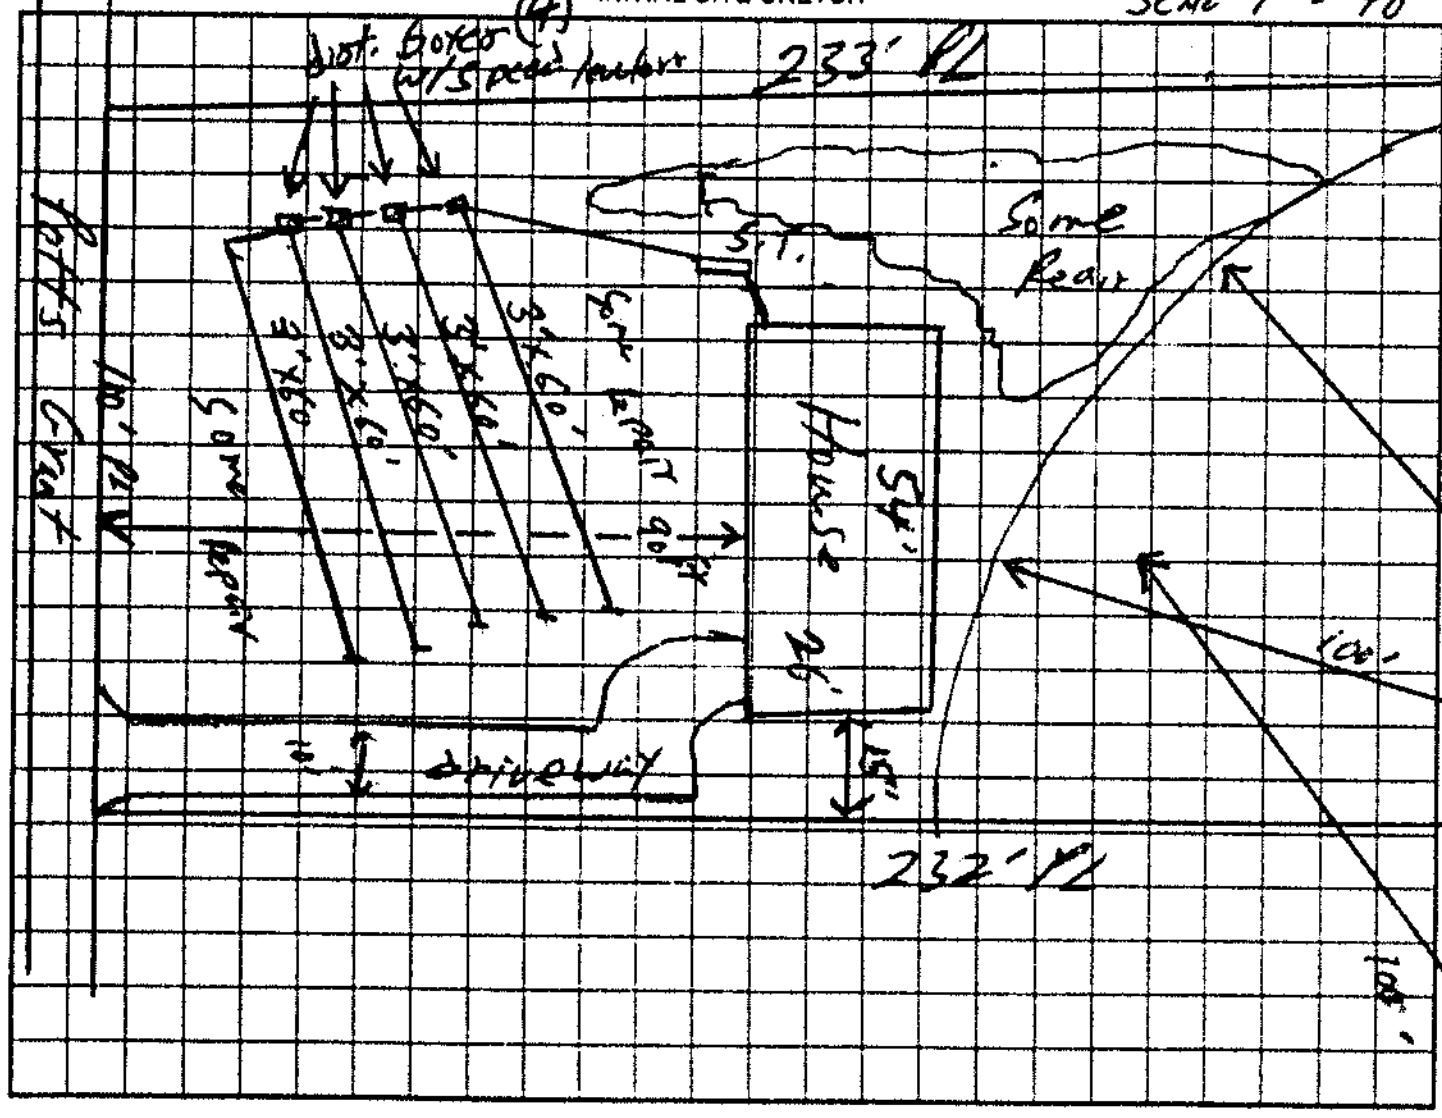

AS BUILT SKETCH

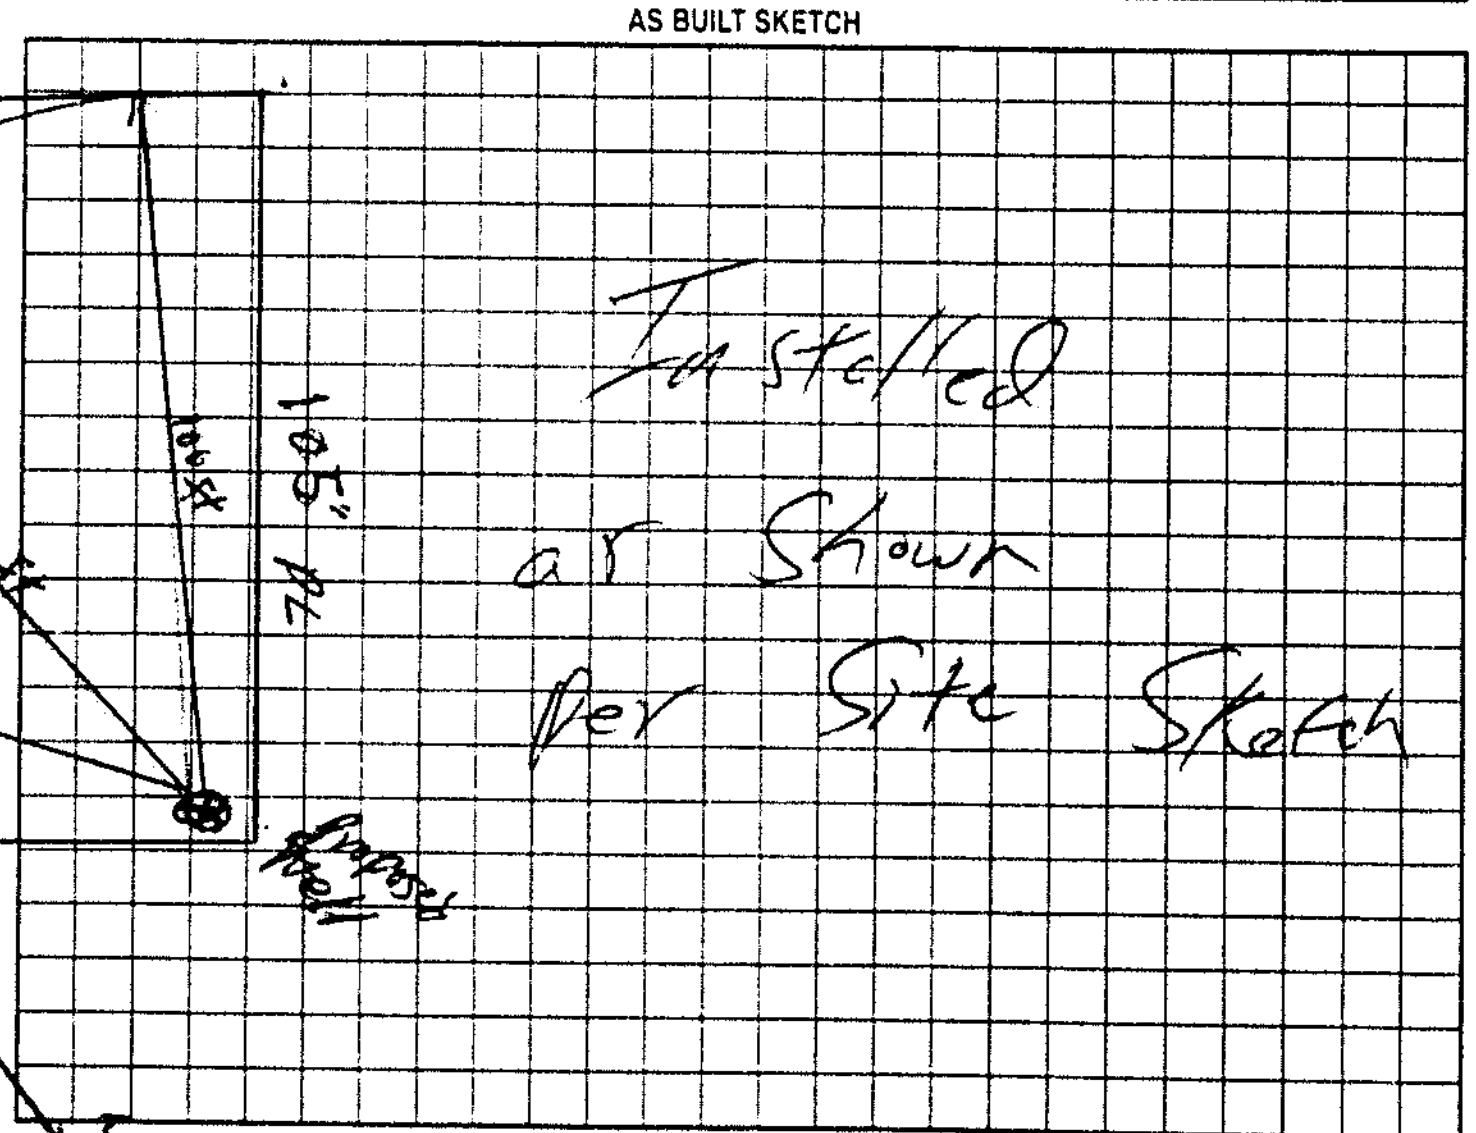

Permit can be suspended or revoked if any false information is supplied toward securing the permit/any unauthorized changes are made to the site any unauthorized changes are made in the installation of the system. Improvement Permit with plat valid without expiration. Improvement Permit with site plan valid for sixty months. Authorization to Construct is valid for a period equal to that of Improvement Permit – not to exceed sixty months.

Signed: [signature] date 4/23/02 Installed by: Rowan Septic

Improvement Permit by: William O. Johnson date 4/19/02 Operation Permit by: William O. Johnson date 5/6/02

Authorization to Construct by: William O. Johnson date 4/19/02 Existing System Inspection by: date

HEALTH DEPT COPY WHITE OWNER COPY (FINAL) YELLOW OWNER COPY (INITIAL) PINK