This Permit Voids Previously issued Permit dated 10-20-97.

IREDELL COUNTY HEALTH DEPARTMENT

STATESVILLE 704-878-5305 / MOORESVILLE 704-664-5281

IMPROVEMENT PERMIT / AUTHORIZATION TO CONSTRUCT / OPERATION PERMIT / EXISTING SYSTEM INSPECTION

PERMIT# 066333 PIN# 4727156262 DATE 1/8/02

OWNER OR CONTRACTOR Bob Haden / William Kenotiz PHONE: Business 833-1365 Home

ADDRESS 349 Gilbert Road Statesville, NC 28677

LOCATION 115 N. on Coachman Loop on Trinity Rd on Pitts Grant Road, lot on ~~right~~ left

SUBDIVISION Midway Park BLOCK / SECTION — LOT 7 LOT AREA 100x231 SITE CLASS. PS DESIGN FLOW 360 L.T.A.R. - 30

Septic Tank: 1000 Gallons; STB 1012 Date 8-19-01
Pump Tank: Gallons; PT Date
Pump Make: Model Serial No.
Nitrification Field: No Fields 1 Square Feet 97 to 200 Linear Feet 200
No Lines 5 to 40' Trench Width 24" Max Trench Bottom Depth 36" Stone Depth 6"

X New System ☐ Repair System Type: I, II, III, IV, V, VI
System Description: Gravity / Gravel System
Repair System Description: Pump PPBPS
Maintenance Agreement Required: ☐ Yes X No


X House/Mod. Home No. Bedrooms 3
☐ Mobile Home No. Bathrooms 2
☐ Business No. Employees
☐ Other
☐ Slab X Crawl Space ☐ Basement w/plumbing ☐ Basement wo/plumbing

Water Supply: X Individual ☐ Public ☐ Community


Comments:/Conditions: ① Install 45 panels w/ distribution box and 33 tons of sand ② Maintain proper setbacks

Comments:/Conditions - St. marker Installed
- Poly tank Filler Installed
- 45 panels Installed

INITIAL SITE SKETCH

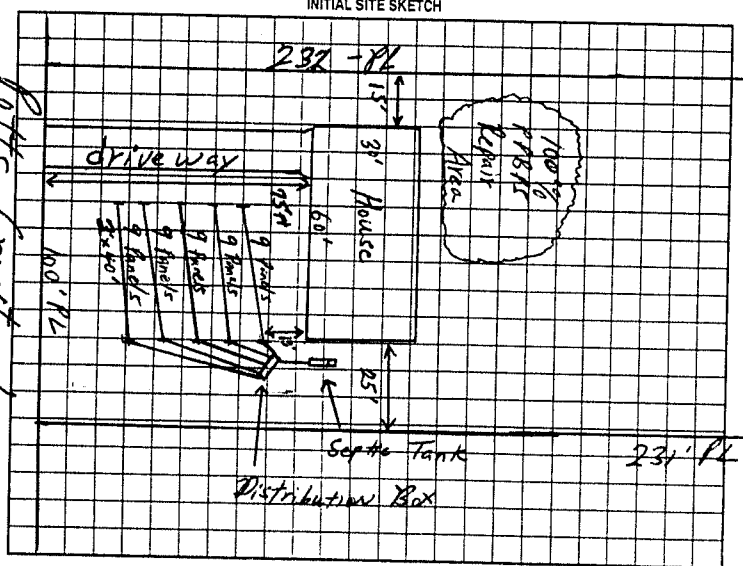

AS BUILT SKETCH

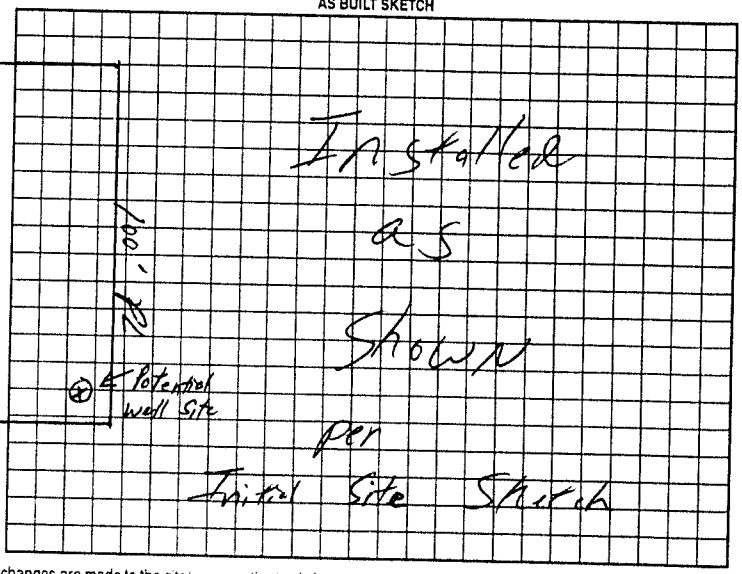

Permit can be suspended or revoked if any false information is supplied toward securing the permit/any unauthorized changes are made to the site/any unauthorized changes are made in the installation of the system. Improvement Permit with plat valid without expiration. Improvement Permit with site plan valid for sixty months. Authorization to Construct is valid for a period equal to that of Improvement Permit – not to exceed sixty months.

Signed: Sean DeHoyos date 1/8/02 Installed by: Mitchell Grading

Improvement Permit by: William O. Johnson date 1/8/02 Operation Permit by: William O. Johnson date 1/11/02

Authorization to Construct by: William O. Johnson date 1/7/02 Existing System Inspection by: date

HEALTH DEPT COPY: WHITE OWNER COPY (FINAL): YELLOW OWNER COPY (INITIAL): PINK