This Permit Voids previously issued permit dated 10-20-99.

IREDELL COUNTY HEALTH DEPARTMENT

STATESVILLE 704-878-5305 ✓ MOORESVILLE 704-664-5281

IMPROVEMENT PERMIT / AUTHORIZATION TO CONSTRUCT / OPERATION PERMIT / EXISTING SYSTEM INSPECTION

PERMIT# 066331 PIN# 4727-15-6351 DATE 1/8/02

OWNER OR CONTRACTOR Bob Haden / William Bienotiz PHONE: Business 838-1365 Home

ADDRESS 349 Gilbert Road Statesville, N.C. 28677

LOCATION NC 115 N. @ on Coachmen Loop @ on Trinity Road @ on Potts Grant Rd lots on left

SUBDIVISION Midway Park BLOCK / SECTION LOT 8 LOT AREA 100x231 SITE CLASS IS DESIGN FLOW 360 L.T.A.R. .30 COMFT2

Septic Tank: 4000 Gallons; STB 1012 Date 9-04-01
Pump Tank: Gallons; PT Date
Pump Make: Model Serial No.
Nitrification Field: No Fields 1 Square Feet 1200 Linear Feet 200
No Lines 10 Trench Width 24" Max Trench Bottom Depth 36" Gravel Depth 6"

☒ New System ☐ Repair System Type: I, II, III, IV, V, VI
System Description: Gravity, PPBPS
Repair System Description: Pump PPBPS
Maintenance Agreement Required: ☐ Yes ☐ No
☐ Slab ☒ Crawl Space ☐ Basement w/plumbing ☐ Basement wo/plumbing


☒ House/Mod. Home No. Bedrooms 3
☐ Mobile Home No. Bathrooms 2
☐ Business No. Employees
☐ Other

Water Supply: ☒ Individual ☐ Public ☐ Community


Comments/Conditions: ① Install 45 Panels w/ distribution box and 33 feet of Sand ② Maintain proper Set backs

Comments/Conditions: Installed 45 PPBPS -ST marker Installed - Polylok Filter Installed

INITIAL SITE SKETCH

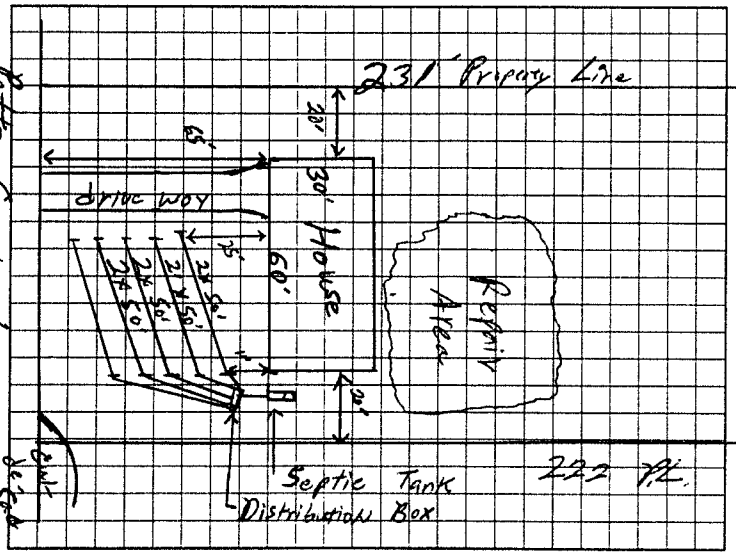

AS BUILT SKETCH

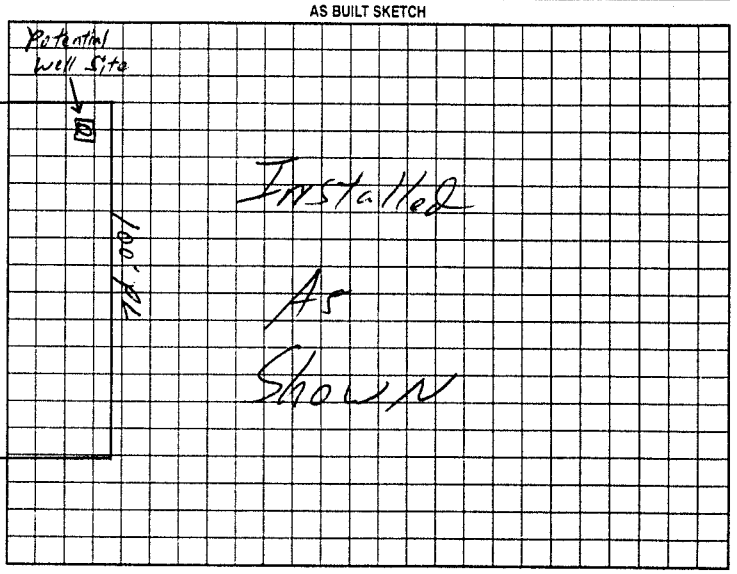

Permit can be suspended or revoked if any false information is supplied toward securing the permit/any unauthorized changes are made to the site/any unauthorized changes are made in the installation of the system. Improvement Permit with plat valid without expiration. Improvement Permit with site plan valid for sixty months. Authorization to Construct is valid for a period equal to that of Improvement Permit – not to exceed sixty months.

Signed: Dean DeHoyos date 1/8/02 Installed by: Mitchell Grading

Improvement Permit by: William E. Johnson date 1/8/02 Operation Permit by: William E. Johnson date 1/18/02

Authorization to Construct by: William E. Johnson date 1/8/02 Existing System Inspection by: date

HEALTH DEPT. COPY WHITE OWNER COPY (FINAL) YELLOW OWNER COPY (INITIAL) PINK