IREDELL COUNTY HEALTH DEPARTMENT

STATESVILLE 704-878-5305 ✓ MOORESVILLE 704-664-5281

IMPROVEMENT PERMIT / AUTHORIZATION TO CONSTRUCT / OPERATION PERMIT / EXISTING SYSTEM INSPECTION

PERMIT# 103806 PIN# 4927-15-6534 DATE 2/1/02

OWNER OR CONTRACTOR Pilot Builders PHONE: Business 202-4964 Home

ADDRESS 1287 Bagnal Blvd Statesville N.C. 28677

LOCATION Hwy 115N, Glen Cochrans Rd. @ on Trinity, @ on Potts-Grant at end.

SUBDIVISION Midway Park BLOCK / SECTION LOT 10 LOT AREA .61 Ac. SITE CLASS PS DESIGN FLOW 360 L.T.A.R. .30

Septic Tank: 4000 Gallons; STB 825 Date 12/3-01
Pump Tank: Gallons; PT Date
Pump Make: Model Serial No.
Nitrification Field: No Fields 1 Square Feet 1200 Linear Feet 400'
No Lines Serial Trench Width 36" Max Trench Bottom Depth 30" Gravel Depth 12

☒ New System ☐ Repair System Type: I II III IV V VI
System Description: Gravity, Conventional
Repair System Description: Pump, 50% Reduction
Maintenance Agreement Required: ☐ Yes ☐ No

☒ House/Mod. Home No. Bedrooms 3
☐ Mobile Home No. Bathrooms 2
☐ Business No. Employees
☐ Other


☐ Slab ☒ Crawl Space ☐ Basement w/plumbing ☐ Basement wo/plumbing

Water Supply: ☒ Individual ☐ Public ☐ Community


Comments/Conditions:

Comments/Conditions: Poly Lake filter Installed 3 Liner Installed. Keep well 100 ft from System

INITIAL SITE SKETCH

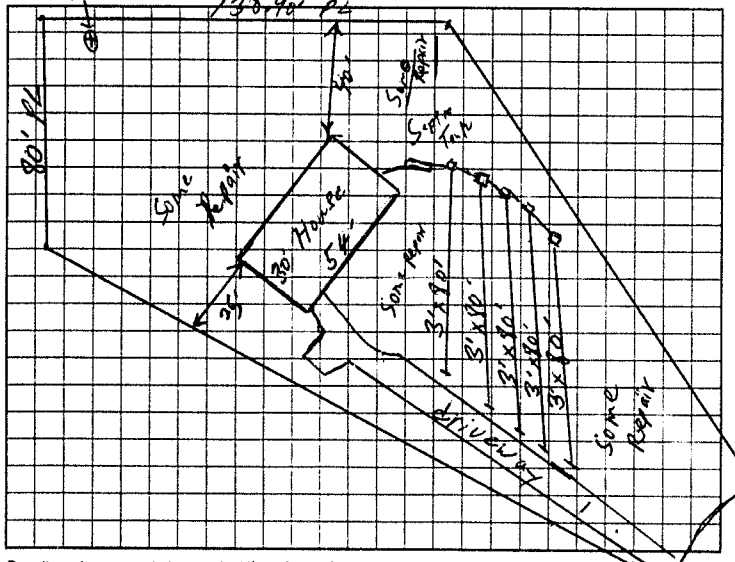

AS BUILT SKETCH

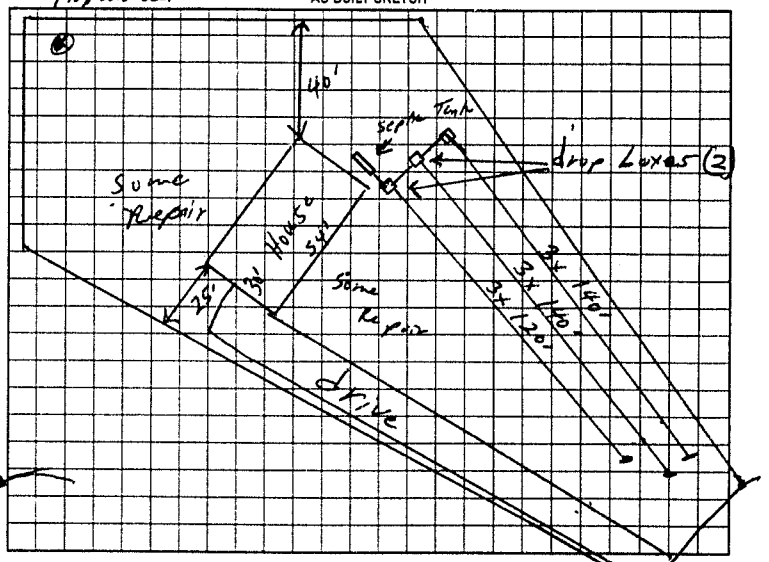

Permit can be suspended or revoked if any false information is supplied toward securing the permit/any unauthorized changes are made to the site/any unauthorized changes are made in the installation of the system. Improvement Permit with plat valid without expiration. Improvement Permit with site plan valid for sixty months. Authorization to Construct is valid for a period equal to that of Improvement Permit - not to exceed sixty months.

Signed: date 2/1/02 Installed by: Rowan Septic + Grading

Improvement Permit by: William O. Johnson date 2/1/02 Operation Permit by: William O. Johnson date 1/26/02

Authorization to Construct by: William O. Johnson date 2/1/02 Existing System Inspection by: date

HEALTH DEPT COPY WHITE OWNER COPY (FINAL) YELLOW OWNER COPY (INITIAL) PINK