IREDELL COUNTY HEALTH DEPARTMENT

STATESVILLE 704-878-5305 (C1) MOORESVILLE 704-664-5281

IMPROVEMENT PERMIT / AUTHORIZATION TO CONSTRUCT / OPERATION PERMIT / EXISTING SYSTEM INSPECTION

(C1)

PERMIT# 123023 PIN# 4727-23-3705 DATE 8-11-04

OWNER OR CONTRACTOR HAROLD KILPATRICK, SR PHONE: Business 704-202-4971 Home 704-876-6162

ADDRESS 823 JENNINGS ROAD, STATESVILLE, NC 28625

LOCATION NC 115 North, TR COACHMAN'S LOOP, TL TRINITY ROAD, 0.7 MILE ON LEFT

SUBDIVISION _____ BLOCK / SECTION _____ LOT _____ LOT AREA 7.82 ACRES SITE CLASS PS DESIGN FLOW 360 L.T.A.R. 0.30 GPD/FT²

Septic Tank: 1000 Gallons; STB 825 Date 10-15-04
Pump Tank: _____ Gallons; PT _____ Date _____
Pump Make: _____ Model _____ Serial No. _____
Nitrification Field: No Fields 1 Square Feet SR. TO 1200 Linear Feet 400
No Lines FOUR Trench Width 36" Max Trench Bottom Depth 36" Gravel Depth 12"

☑ New System ☐ Repair System Type: I (II) III, IV, V, VI
System Description: CONVENTIONAL GRAVITY
Repair System Description: CONVENTIONAL, PUMP
Maintenance Agreement Required: ☐ Yes ☑ No


☑ House/Mod. Home No. Bedrooms 3
☐ Mobile Home No. Bathrooms ____
☐ Business No. Employees ____
☐ Other _____
☐ Slab ☑ Crawl Space ☐ Basement w/plumbing ☐ Basement wo/plumbing

Water Supply: ☑ Individual ☐ Public ☐ Community WELL


Comments:/Conditions: INSTALL SUBSURFACE INTERCEPT DRAINAGE DITCH AT LOCATION SHOWN BEGINNING 48" DEEP, CONTINUE 48" DEEP AROUND SYSTEM, THEN OUT TO DAYLIGHT

Comments:/Conditions: SEPTIC TANK WITH MARKER INSTALLED USING "Poly Lok" FILTER

INITIAL SITE SKETCH

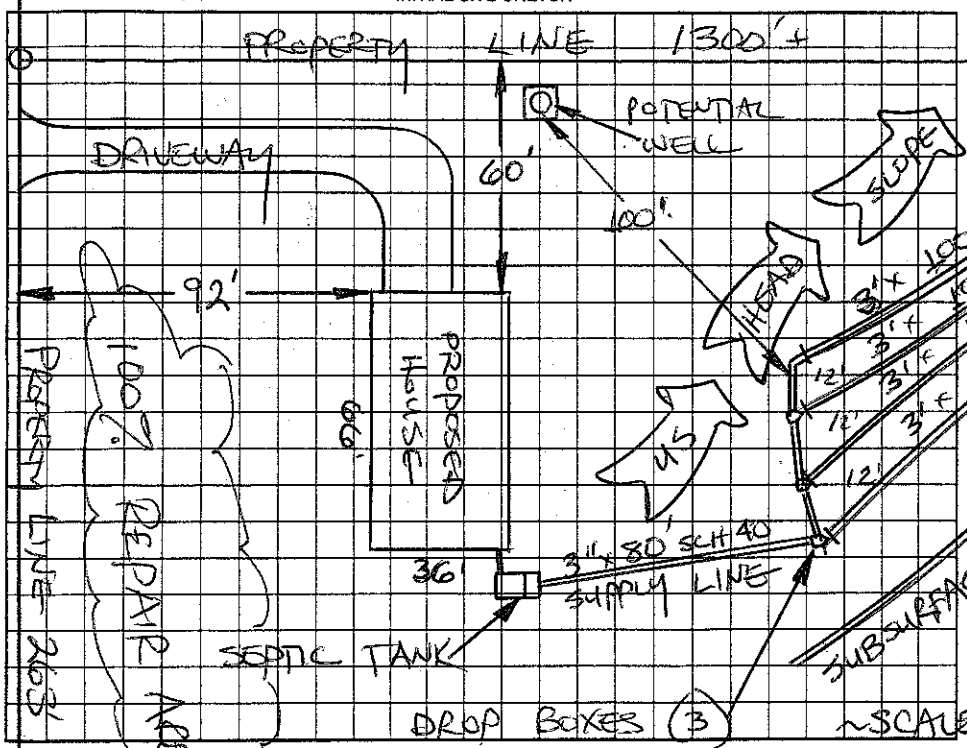

AS BUILT SKETCH

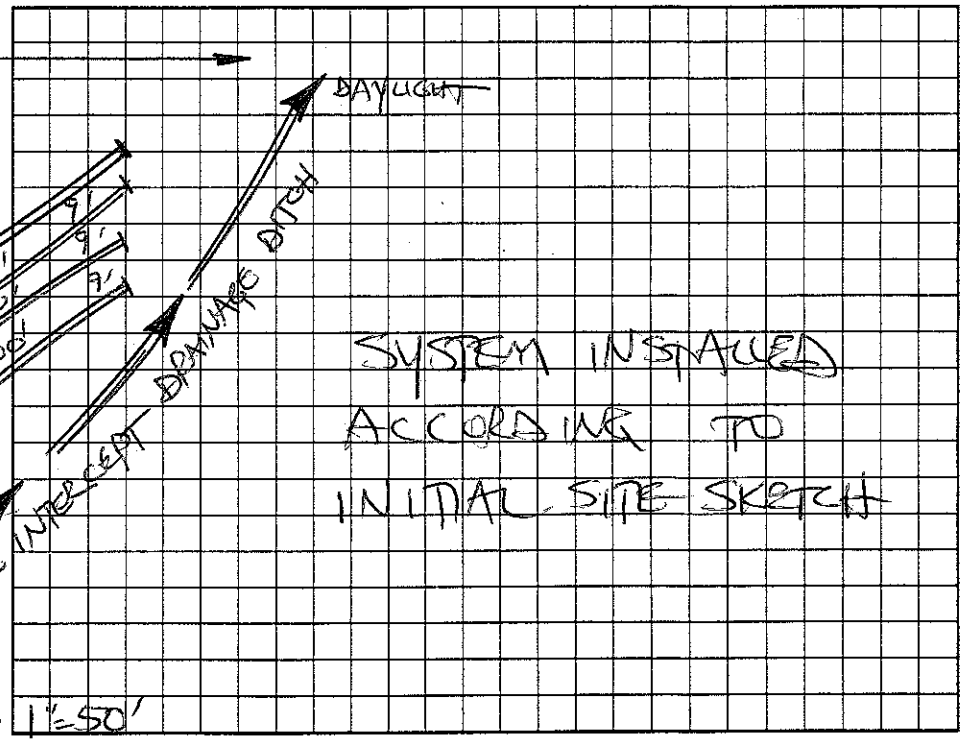

TRINITY ROAD (SR 1554)

Permit can be suspended or revoked if any false information is supplied toward securing the permit/any unauthorized changes are made to the site/any unauthorized changes are made in the installation of the system. Improvement Permit with plat valid without expiration. Improvement Permit with site plan valid for sixty months. Authorization to Construct is valid for a period equal to that of Improvement Permit – not to exceed sixty months.

Signed: _____ date 8-16-04 Installed by: ROWAN SEPTIC

Improvement Permit by: STEVE HEDRICK date 8-11-04 Operation Permit by: STEVE HEDRICK date 12-30-04

Authorization to Construct by: STEVE HEDRICK date 8-11-04 Existing System Inspection by: _____ date _____

HEALTH DEPT. COPY: WHITE OWNER COPY (FINAL): YELLOW OWNER COPY (INITIAL): PINK