48653

IREDELL COUNTY HEALTH DEPARTMENT

STATESVILLE 704-878-5305 MOORESVILLE 704-664-5281

IMPROVEMENT PERMIT / CERTIFICATE OF COMPLETION/ OPERATION PERMIT / EXISTING SYSTEM INSPECTION

PROPERTY DESCRIPTION NO. 10693 DATE 7/27/93 TAX MAP NO. 9M-1-A-21

OWNER OR CONTRACTOR PHYLLIS HAMBY PHONE: Business Home 871-8117

ADDRESS RT 2 BOX 240, STATESVILLE NC 28677

LOCATION NC 115 N TO COACHMAN LOOP, TL TRINITY ROAD ~ 1 MILE ON (R) AT MIDWAY PARK

SUBDIVISION MIDWAY PARK BLOCK / SECTION LOT 21 LOT AREA 119 x 170' SITE CLASS. PS L.T.A.R. 0.30 GPD/FT2

Water Supply: ☑ Individual ☐ Community ☐ Public WELL

Septic Tank: 1000 Gallons; STB 358 Date 9/10/93

Pump Tank: Gallons; PT Date

Nitrification Field: No Fields 1 Square Feet 810 Linear Feet 270

No Lines 3 Trench Width 36" Trench Depth 18-36" Gravel Depth 12"

☑ New System ☐ Repair System Type: I (II) III IV V VI

System Description: CONV. GRAVITY

Repair System Description: CONV. GRAVITY

Maintenance Agreement Required: ☐ Yes ☑ No

☑ House/Mod. Home ☐ Mobile Home ☐ Business ☐ Other


No. Bedrooms 2 No. Bathrooms 2 No. Employees

Garbage Disposal: ☐ Yes ☑ No Auto. Dishwasher: ☑ Yes ☐ No Auto. Washing Machine: ☑ Yes ☐ No Other


☑ Slab ☐ Crawl Space ☐ Basement w/plumbing ☐ Basement wo/plumbing

Comments (1) KEEP SYSTEM MINIMUM 5' FROM HOUSE, 10' FROM PROPERTY LINE, 100' WELL (2) INSTALL LINES 9' APART ON CENTER, NO DEEPER THAN 36" ON CONTOUR,

INITIAL SITE SKETCH

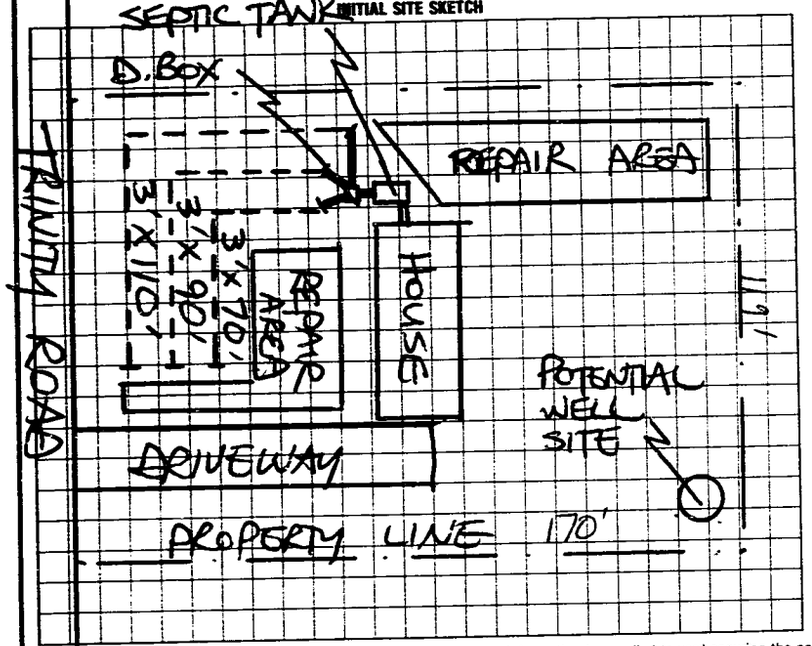

AS BUILT SKETCH

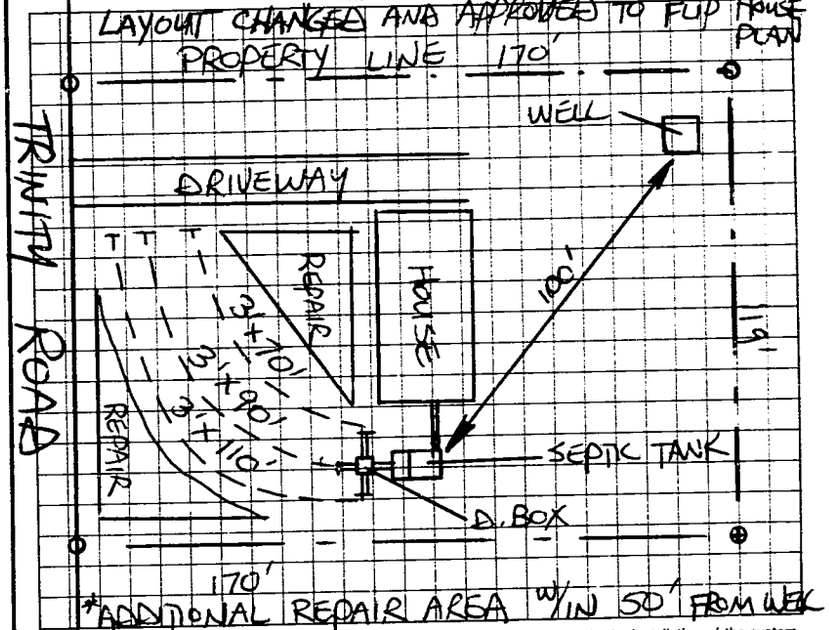

I understand that this permit can be suspended or revoked if any false information is supplied toward securing the permit/any unauthorized changes are made to the site/any unauthorized changes are made in the installation of the system. Improvement Permit is valid for 60 months from date of issuance.

Signed: X Phyllis Hamby

Improvement Permit by: STEVE HERRICK date 7/27/93

Existing System Inspection by: date

Installed by: DONALD LACKEY

Certificate of Completion by: STEVE HERRICK date 10/25/93

Operation Permit by: date

HEALTH DEPT. COPY: WHITE INSPECTION COPY (FINAL): GREEN OWNER COPY (FINAL): YELLOW INSPECTION COPY (INITIAL): PINK OWNER COPY (INITIAL): GOLD

J