# IREDELL COUNTY HEALTH DEPARTMENT

STATESVILLE 704-878-5305 @ MOORESVILLE 704-664-5281

## IMPROVEMENT PERMIT / AUTHORIZATION TO CONSTRUCT / OPERATION PERMIT / EXISTING SYSTEM INSPECTION

PERMIT# 152793 PIN# 4727-36-5536 DATE 22 October 08

OWNER OR APPLICANT Harry Watt PHONE: Business 704-880-5034 x611 Home

ADDRESS 132 Beckam Rd. Statesville, N.C.

LOCATION 115 N TL Weston Rd. TR Beckam Rd. First Drive on RT.

SUBDIVISION BLOCK / SECTION LOT LOT AREA 3.812 Ac. SITE CLASS. PS DESIGN FLOW 360 g/d L.T.A.R. 0.36 g/ft²/d

Septic Tank: 1000 Gallons: STB 763 Date 6-22-10

Pump Tank: Gallons: PT Date

Pump Make: Model Serial No.

Nitrification Field: No Fields 1 Square Feet 1200 Linear Feet 300

No Lines 3 Trench Width 36" Max Trench Bottom Depth 36" Gravel Depth

☑ New System ☐ Repair ☐ Expansion System Type: I II III IV V VI

System Description: 25% Reduction

Repair System Description: 25% Reduction

Maintenance Agreement Required: ☐ Yes ☑ No

☑ House/Mod. Home No. Bedrooms 3

☐ Mobile Home No. Persons

☐ Business No. Employees

☐ Other

Water Supply: ☑ Individual ☐ Public ☐ Community

☑ Gravity ☐ Pressure ☑ Slab ☐ Crawl Space ☐ Basement w/plumbing ☐ Basement wo/plumbing

Comments:/Conditions: Follow Contour / Honor all setback requirements.


Comments:/Conditions: Poly lock filter

ST has marker

INITIAL SITE SKETCH

Please see Attached Site Sketch

AS BUILT SKETCH

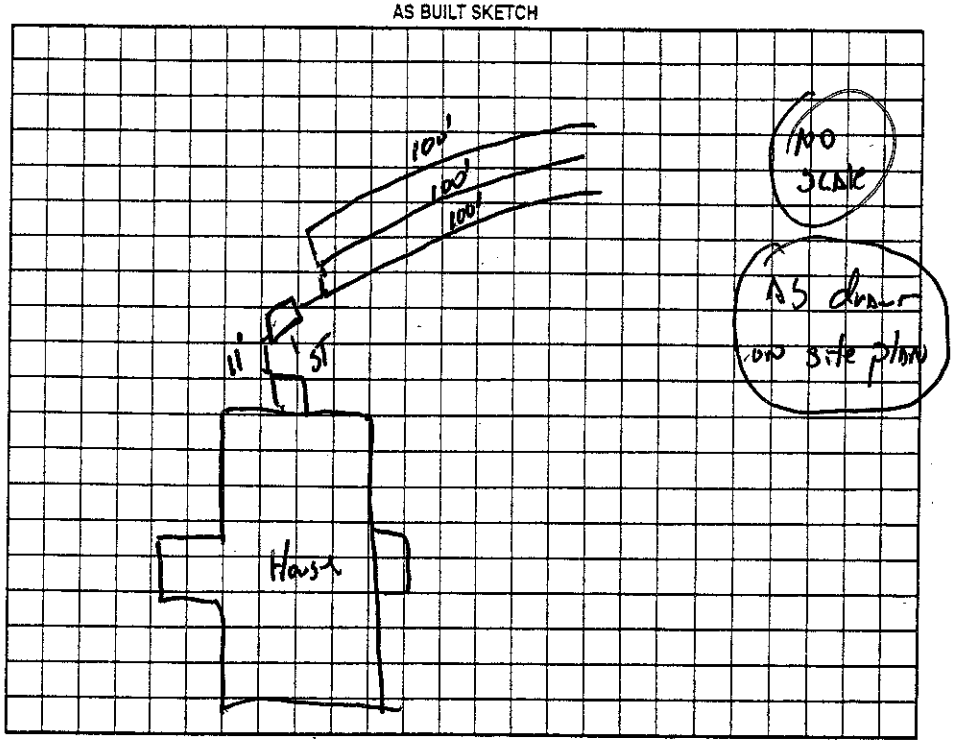


Permit can be suspended or revoked if any false information is supplied toward securing the permit/any unauthorized changes are made to the site/any unauthorized changes are made in the installation of the system. Improvement Permit with plat valid without expiration ☐ Improvement Permit with site plan valid for sixty months ☑ Authorization to Construct is valid for a period equal to that of Improvement Permit – not to exceed sixty months.

Signed: Harry W. Watt date 11-10-08 Installed by: James Huddle

Improvement Permit by: R.S. date 22 Oct. 08 Operation Permit by: R.S. date 1 November 08

Authorization to Construct by: R.S. date 22 Oct. 08 Existing System Inspection by: date

HEALTH DEPT. COPY: WHITE OWNER COPY (FINAL): YELLOW OWNER COPY (INITIAL): PINK