EDELL COUNTY HEALTH DEPARTMENT - *ENVIRONMENTAL HEALTH* ☐ STATESVILLE OFFICE 704-878-5305 ☐ MOORESVILLE OFFICE 704-664-5281

IMPROVEMENT PERMIT / AUTHORIZATION TO CONSTRUCT / OPERATION PERMIT / EXISTING SYSTEM INSPECTION

PERMIT # 172559 PIN # ~~4727-27-4952~~ 4727372461 DATE JUNE 8, 2012

OWNER NATHANIEL SNYDER APPLICANT: SAME PHONE: Home/Cell # 704-546-5843 Business # ~~704-881-3097~~

SITE ADDRESS 154 BECKHAM ROAD OWNER / APPLICANT ADDRESS 650 BUTLER MILL RAD, HARMONY NC 28634

SITE DIRECTIONS NC 115 N, TL WESTON RD, TR BECKHAM RAD, ON RIGHT ACROSS FROM #157.

SUBDIVISION BLOCK / SECTION LOT # LOT AREA 1.0 ACRE DESIGN FLOW 360 L.T.A.R. 0.30 GPD/FT2

Septic Tank 1000 Gallons: STB 760 Date 1-8-12

Pump Tank Gallons: P T Date

Pump Make Model Serial #

No. Nitrification Fields: 1 No. Lines 3 Linear Feet 300

Trench Width 36" Max. Trench Bottom Depth 36" Gravel Depth NA

☑ New System ☐ Repair ☐ Expansion System Type I II (III) IV V VI

System Description: 25% REDUCTION, GRAVITY

Repair System Description: 25% REDUCTION, GRAVITY

Maintenance Agreement Required ☐ YES ☑ NO

☑ GRAVITY ☐ PRESSURE

☑ Residence No. Bedrooms 3

☐ Business No. Persons

☐ Other No. Employees

☐ Slab ☑ Crawl Space


☐ Basement w/plumbing ☐ Basement w/o plumbing

Water Supply: ☑ Private ☐ Public ☐ Community


Comments / Conditions: INSTALL 25% REDUCTION SYSTEM ON CONTOUR AS FLAGGED ON SITE ② KEEP SYSTEM MINIMUM 5' FROM ANY BUILDING FOUNDATION, 100' FROM ANY WELL, 10' FROM PROPERTY LINE

Red Polylok Filter installed
Infiltrator Quick 4 Installed

INITIAL SITE SKETCH

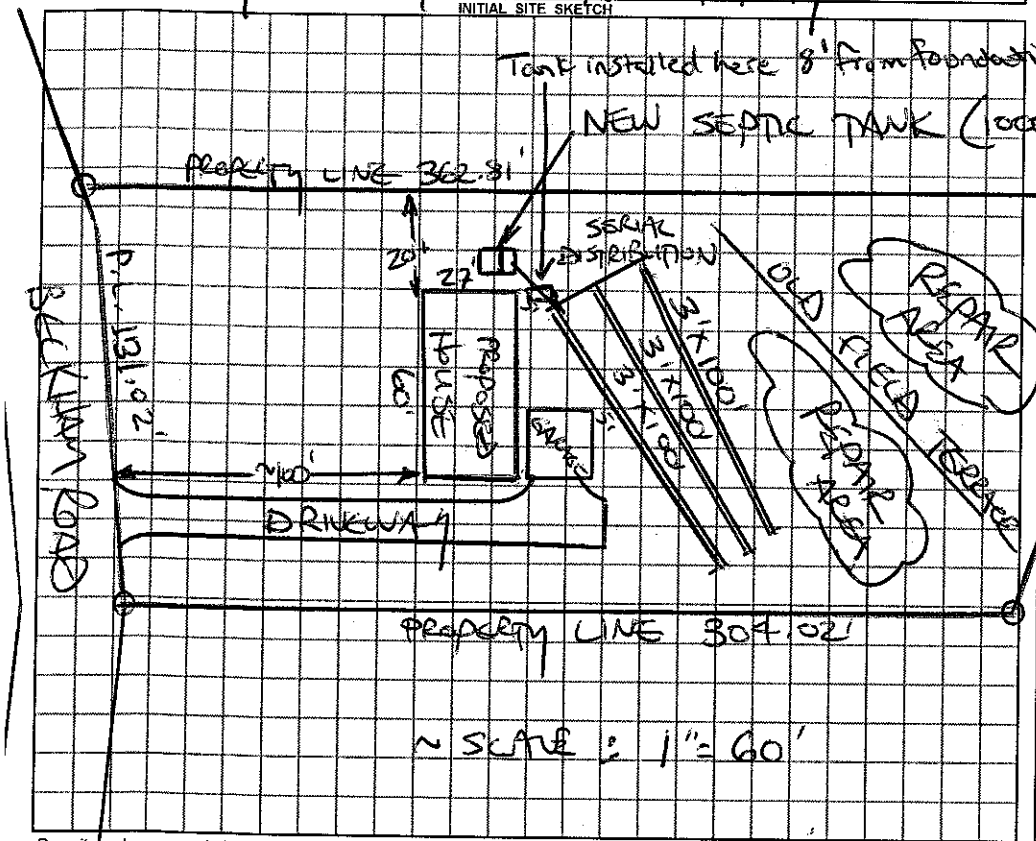

AS BUILT SKETCH

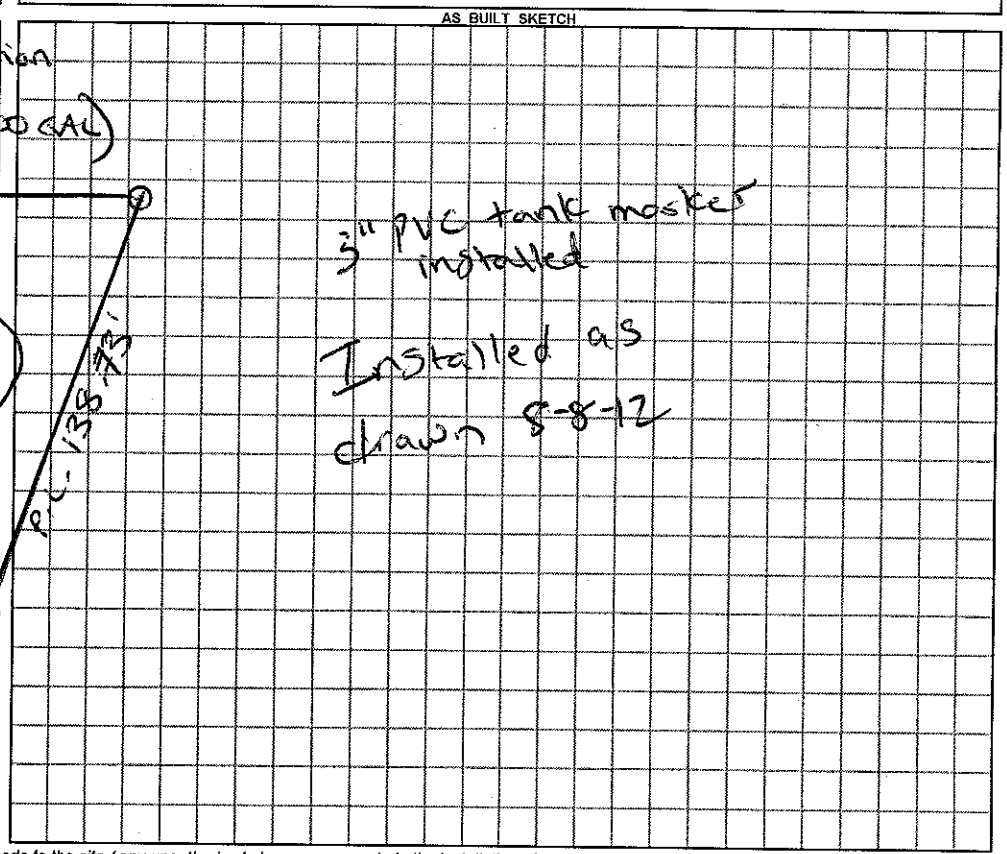

Permit can be suspended or revoked if any false information is supplied toward securing the permit / any unauthorized changes are made to the site / any unauthorized changes are made in the installation of the system.

☐ ***IMPROVEMENT PERMIT*** with plat valid without expiration. ☑ ***IMPROVEMENT PERMIT*** with plat ~~valid without expiration~~ ***site plan valid 60 mo.*** ☑ ***AUTHORIZATION TO CONSTRUCT*** valid for period equal to IMPROVEMENT PERMIT--not to exceed 60 mo.

Owner / Applicant Signature: Nathaniel V Snyder Date

IMPROVEMENT PERMIT by: STEVE HEDRICK REHS Date 6/8/12

AUTHORIZATION TO CONSTRUCT by: STEVE HEDRICK REHS Date 6/8/12

YOU SHOULD CONTACT A LOCATOR SERVICE PRIOR TO ANY EXCAVATION

Installed by: Al Backhoe

OPERATION PERMIT by: Justin Henderson REHS Date 8-8-12

Existing System Inspected by: REHS Date

White Copy – Environmental Health YELLOW COPY (Final) Owner / Applicant PINK COPY (Initial) Owner / Applicant