IREDELL COUNTY HEALTH DEPARTMENT

STATESVILLE 704-878-5305 MOORESVILLE 704-664-5281

IMPROVEMENT PERMIT / AUTHORIZATION TO CONSTRUCT / OPERATION PERMIT / EXISTING SYSTEM INSPECTION

PERMIT# REPAIR PIN# 4727-38-1142 DATE 4-13-05

OWNER OR CONTRACTOR CHARLES & NANCY BECKHAM PHONE: Business (704) 682-0008 Home (704) 876-3419

ADDRESS 202 BECKHAM RD STATESVILLE NC 28625

LOCATION HWY 115 N TL WESTON RD TR BECKHAM RD LOT AT END ON RIGHT

SUBDIVISION _____ BLOCK / SECTION _____ LOT _____ LOT AREA 1.00 SITE CLASS PS DESIGN FLOW 360 L.T.A.R. EXISTING

Septic Tank: EXISTING Gallons; STB _____ Date _____
Pump Tank: _____ Gallons; PT _____ Date _____
Pump Make: _____ Model _____ Serial No. _____
Nitrification Field: No Fields 1 Square Feet _____ Linear Feet 200
No Lines 2 Trench Width 36" Max Trench Bottom Depth 36" Gravel Depth 24"

☐ New System ☑ Repair System Type: I (II) III, IV, V, VI
System Description: _____
Repair System Description: CONVENTIONAL GRAVITY
Maintenance Agreement Required: ☐ Yes ☑ No


☐ House/Mod. Home No. Bedrooms 3
☑ Mobile Home No. Bathrooms _____
☐ Business No. Employees _____
☐ Other _____
☐ Slab ☑ Crawl Space ☐ Basement w/plumbing ☐ Basement wo/plumbing

Water Supply: ☑ Individual ☐ Public ☐ Community

Comments/Conditions: ① REPAIR TO EXISTING SYSTEM ② INSTALL SYSTEM ON CONTOUR ③ MAINTAIN SETBACKS ④ PUMP OUT TANK & INSTALL FILTER ⑤ DISCONNECT OLD SYSTEM FROM TANK ⑥ THIS PERMIT SERVES AS A 30 DAY NOV EXPIRING 5-13-05

Comments/Conditions: ① INSTALLED RED POLYLOK FILTER IN TANK ② #57 STONE IN DRAINFIELD

INITIAL SITE SKETCH * 1"=50'

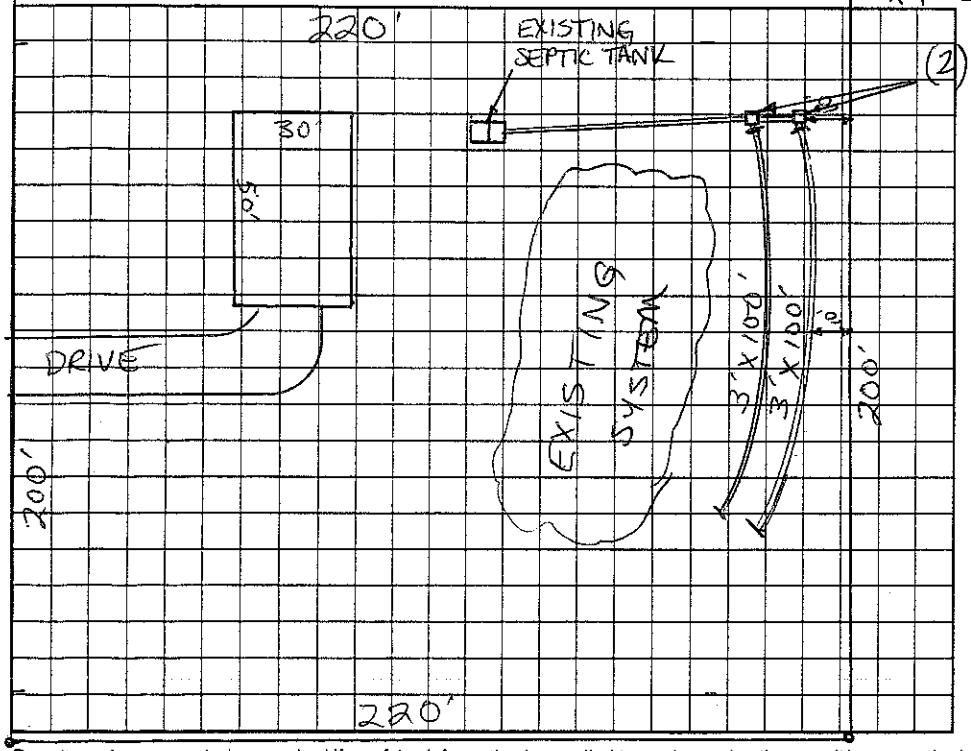

AS BUILT SKETCH

* SYSTEM INSTALLED ACCORDING TO SKETCH

Permit can be suspended or revoked if any false information is supplied toward securing the permit/any unauthorized changes are made to the site/any unauthorized changes are made in the installation of the system. Improvement Permit with plat valid without expiration. Improvement Permit with site plan valid for sixty months. Authorization to Construct is valid for a period equal to that of Improvement Permit – not to exceed sixty months.

Signed: Nancy Beckham date 4-13-05 Installed by: JAMES HUDLER

Improvement Permit by: Christy M. Sherrill RS, LSS date 4-13-05 Operation Permit by: Christy M. Sherrill RS, LSS date 4-25-05

Authorization to Construct by: Christy M. Sherrill RS, LSS date 4-13-05 Existing System Inspection by: _____ date _____

HEALTH DEPT. COPY: WHITE OWNER COPY (FINAL): YELLOW OWNER COPY (INITIAL): PINK