IREDELL COUNTY HEALTH DEPARTMENT

Statesville Office (704) 878-5305 Mooresville Office (704) 660-3625 PERMIT # 200592 BF

IMPROVEMENT PERMIT / AUTHORIZATION TO CONSTRUCT / OPERATION PERMIT / EXISTING SYSTEM

PIN # 4727477969

APPLICANT: Edwin Burks APPLICANT ADDRESS: 3055 Wilkesboro Hwy

SITE ADDRESS: 3055 Wilkesboro Hwy PHONE: 704-876-3985 ALT. PHONE: N/A

SITE DIRECTIONS: Hwy 115 N ~5 miles Property on left across from Lasting Impressions Hair Salon


SUBDIVISION: N/A SECTION: N/A LOT # N/A LOT AREA: 1.5 acres DESIGN FLOW: 360gpd L.T.A.R.: 0.3

Septic Tank	1000	(gal)	STB	1000-760	Date	7-17-13	☐ New System	☑ Repair	☐ Expansion	System Type: I II (III) IV V VI	
Pump Tank		(gal)	PT		Date		System Description:				
Pump Make		Model			Serial #		Repair System Description:	25% Reduction			
# Nitrification Fields	1	# Lines	5		Linear Ft:	280	Maintenance Agreement Required:	☐ YES	☑ NO		
Trench Width	36"	Max. Trench Bottom Depth	36"		Gravel Depth	N/A	☐ GRAVITY	☐ PRESSURE			


☑ Residence	No. Bedrooms	3	Water Supply	
☐ Business	No. Persons	6	☑ Private	
☐ Other	No. Employees		☑ Public	
☐ Slab	☑ Crawl Space		☐ Community	
☐ Basement w/plumbing			☐ Basement w/o plumbing	

Comments / Conditions: Install a 25% Reduction system on contour with Serial distribution. Pump & crush old septic tank. Install new 1000 gallon septic tank @ location shown below.

INITIAL SITE SKETCH

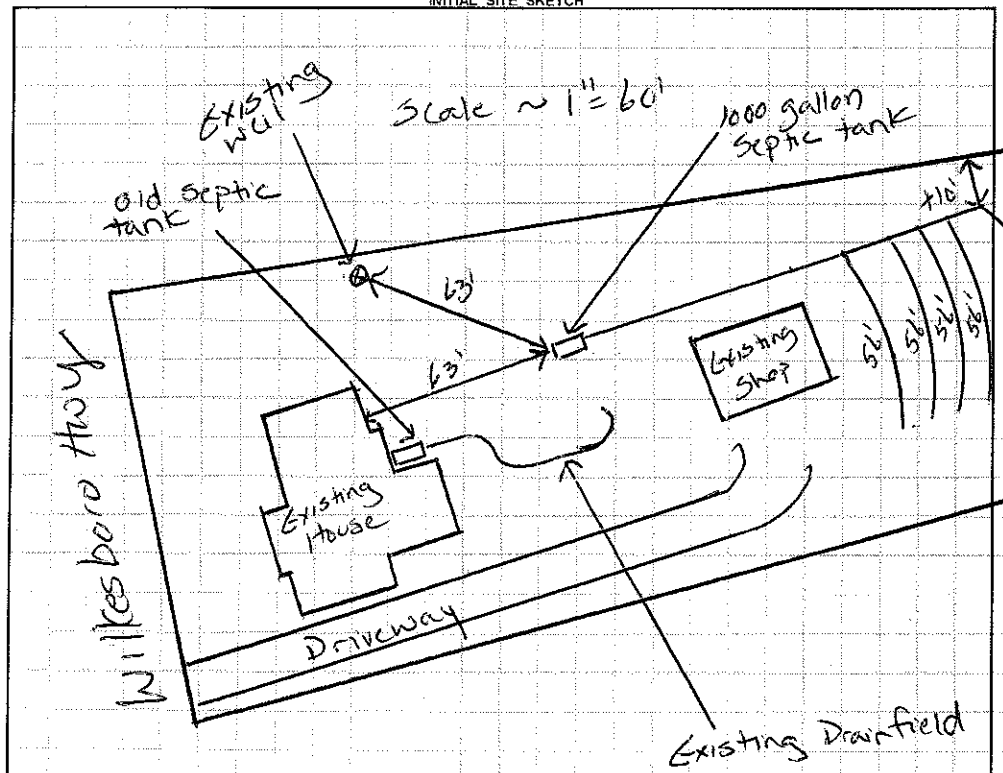

AS BUILT SKETCH

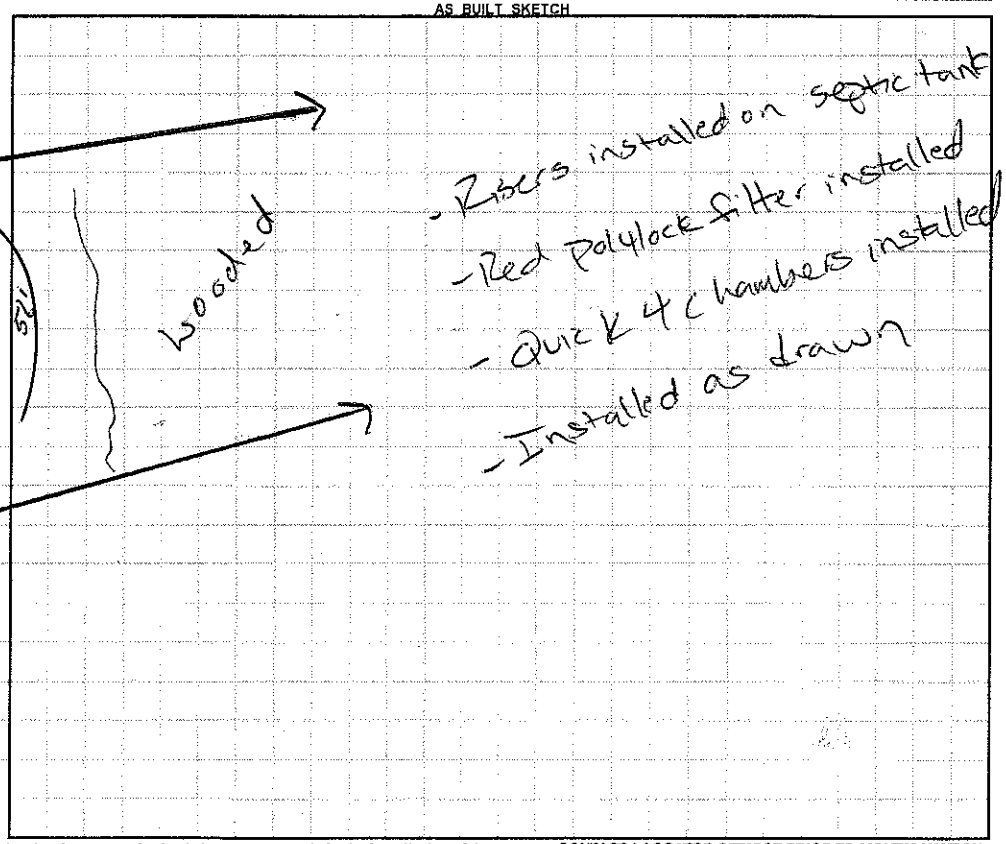

Permit can be suspended or revoked if any false information is supplied toward securing the permit / any unauthorized changes are made to the site / any unauthorized changes are made in the installation of the system. **CONTACT A LOCATOR SERVICE PRIOR TO ANY EXCAVATION**

☐ **IMPROVEMENT PERMIT** ***with plat*** *valid without expiration.* ☑ **IMPROVEMENT PERMIT** ***with site plan*** *valid for 60 mos.* ☑ **AUTHORIZATION TO CONSTRUCT** *valid for period equal to IMPROVEMENT PERMIT--not to exceed 60 mo.*

Owner / Applicant Signature: Edwin Burks Date: Installed by: Lentz Septic

IMPROVEMENT PERMIT by: Justin Henderson Date: 12-12-13 OPERATION PERMIT by: Justin Henderson Date: 12-20-13

AUTHORIZATION TO CONSTRUCT by: Justin Henderson Date: 12-12-13 Existing System Inspected by: Date:

Health Dept. Copy - WHITE Applicant (Final Approval) - YELLOW Applicant (Conditional Approval) - PINK