IREDELL COUNTY HEALTH DEPARTMENT

Statesville Office (704) 878-5305 Mooresville Office (704) 660-3625 PERMIT # 180910

IMPROVEMENT PERMIT / AUTHORIZATION TO CONSTRUCT / OPERATION PERMIT / EXISTING SYSTEM

PIN # 4727479615

APPLICANT: RICHARD BOLLERUP APPLICANT ADDRESS: 126 TREEBARK RD - STATESVILLE NC 28625

SITE ADDRESS: 3029 WILKESBORO HWY - STATESVILLE NC PHONE: ALT. PHONE:

SITE DIRECTIONS: HWY 115(N) - 6 MILES PAST SHEETZ ON RT - # 3029

SUBDIVISION: — SECTION: — LOT # — LOT AREA: 3AC DESIGN FLOW: 100 GPD L.T.A.R.: .25

Septic Tank 1000 (gal) STB 1012 Date 9/2/13
Pump Tank (gal) PT Date
Pump Make Model Serial #
Nitrification Fields 1 # Lines 2 Linear Ft: 100
Trench Width 36" Max. Trench Bottom Depth 36" Gravel Depth N/A


☑ New System ☐ Repair ☐ Expansion System Type: I II (III) IV V VI
System Description: GRAVITY 25% REDUCTION
Repair System Description: GRAVITY 25% REDUCTION
Maintenance Agreement Required: ☐ YES ☑ NO
☑ GRAVITY ☐ PRESSURE

☑ Residence ☑ Business ☐ Other ☐ Slab ☑ Basement w/plumbing
No. Bedrooms No. Persons 4 No. Employees Crawl Space
Water Supply: ☐ Private ☑ Public ☐ Community
☐ Basement w/o plumbing

Comments / Conditions:

*DO NOT ISSUE AC UNTIL FILL MATERIAL IS REMOVED.
* CONTACT IREDELL BEFORE REMOVAL OF FILL MATERIAL.
* SLOPE TO DRAIN OFF OF SEPTIC AREA.

INITIAL SITE SKETCH

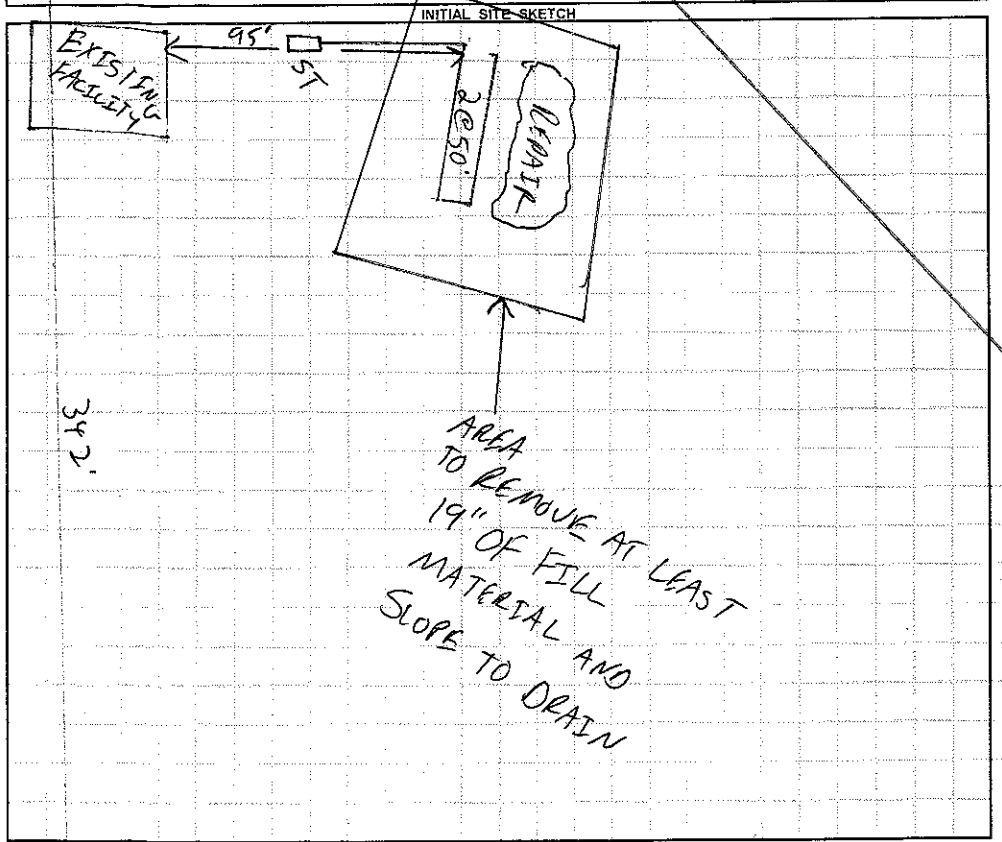

AS BUILT SKETCH

* - MAXIMUM 4 EMPLOYEES AT 25 GALLONS PER PERSON.

* DO NOT PARK ON SEPTIC AREA

Permit can be suspended or revoked if any false information is supplied toward securing the permit / any unauthorized changes are made to the site / any unauthorized changes are made in the installation of the system. **CONTACT A LOCATOR SERVICE PRIOR TO ANY EXCAVATION**

☐ **IMPROVEMENT PERMIT** *with plat valid without expiration.* ☐ **IMPROVEMENT PERMIT** *with site plan valid for 60 mos.* ☑ **AUTHORIZATION TO CONSTRUCT** *valid for period equal to IMPROVEMENT PERMIT--not to exceed 60 mo.*

Applicant Signature: Richard A Bollerup Date: 10/20/13 Installed by: Steve Jordan

PERMIT by: C. Brady Trem Date: 10/17/13 OPERATION PERMIT by: C. Brady Date: 10/25/13

CONSTRUCT by: Date: 10/24/13 Existing System Inspected by: Date:

Health Dept. Copy - WHITE Applicant (Final Approval) - YELLOW Applicant (Conditional Approval) - PINK