9M-A-16 55948

IREDELL COUNTY HEALTH DEPARTMENT

STATESVILLE 704-878-5305 MOORESVILLE 704-664-5281

IMPROVEMENT PERMIT / CERTIFICATE OF COMPLETION / OPERATION PERMIT / EXISTING SYSTEM INSPECTION

PROPERTY DESCRIPTION NO. 23573 DATE 5-4-96 TAX MAP NO. 9M-A-16 Watershed: ☐ Yes ☑ No

OWNER OR CONTRACTOR GARY CONLEY PHONE: Business Home 876-4124

ADDRESS 191 ROUNDHOUSE DRIVE STATESVILLE, NC 28677

LOCATION NC 115 N, R ROUNDHOUSE DRIVE MH ON LEFT AS SHOWN,

SUBDIVISION BLOCK / SECTION LOT LOT AREA AMPLE SITE CLASS. PS DESIGN FLOW 360 L.T.A.R. 0.35 gpd/ft²

Septic Tank: 1000 Gallons; STB 794 Date 9-25-95

Pump Tank: Gallons; PT Date

Pump Make: Model Serial No.

Nitrification Field: No Fields 1 Square Feet 1035 Linear Feet 345

No Lines 3 Trench Width 36" Max Trench Bottom Depth 18-36" Gravel Depth 12"

☑ New System ☐ Repair System Type: I, II, III, IV, V, VI

System Description: CONVENTIONAL GRAVITY

Repair System Description: CONV. GRAVITY

Maintenance Agreement Required: ☐ Yes ☑ No

☐ House/Mod. Home ☐ Mobile Home ☐ Business ☐ Other

No. Bedrooms 3 No. Bathrooms 2 No. Employees


☐ Slab ☑ Crawl Space ☐ Basement w/plumbing ☐ Basement wo/plumbing

Water Supply: ☑ Individual ☐ Community ☐ Public WELL

Comments: 20' to RL

Comments:

INITIAL SITE SKETCH

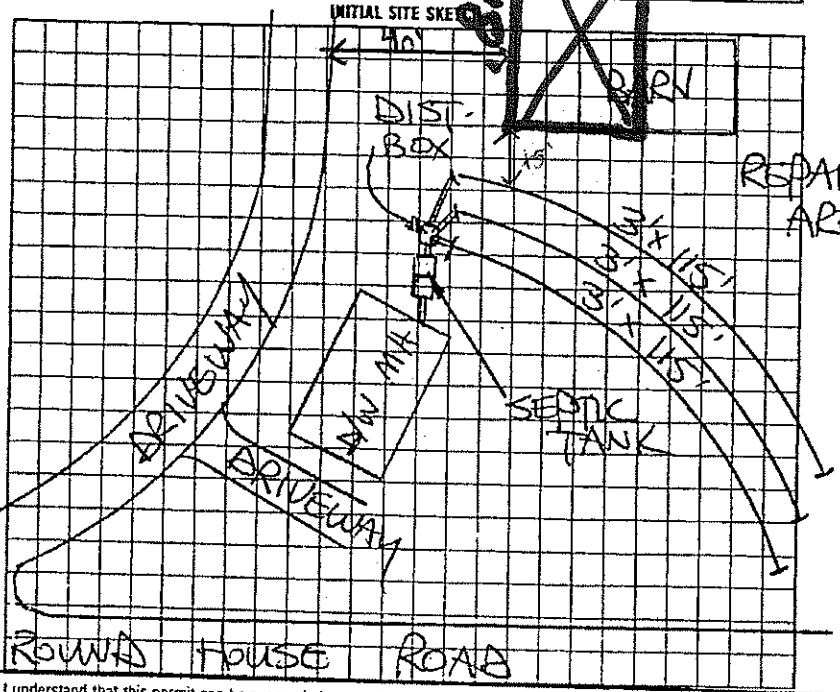

AS BUILT SKETCH

SYSTEM INSTALLED ACCORDING TO INITIAL SITE SKETCH

Location of the proposed 28'X48 Garage addition does not appear to impact the existing on-site septic system.**NOTE:

Justin Mendenhall REHS

Date: 7-16-13

ICHD-Environmental Health Division

I understand that this permit can be suspended or revoked if any false information is supplied toward securing the permit/any unauthorized changes are made to the site/any unauthorized changes are made in the installation of the system. Authorization to Construct is valid five (5) years from date of issuance. Improvement Permit has no expiration date.

Signed: X Gary M. Conley

Improvement Permit by: STEVE HEDRICK date 5-4-96

AUTHORIZATION TO CONSTRUCT: STEVE HEDRICK date 5-4-96

Installed by: JAMES HUDER

Certificate of Completion by: date

Operation Permit by: STEVE HEDRICK date 5-9-96

HEALTH DEPT COPY WHITE INSPECTION COPY (FINAL) GREEN OWNER COPY (FINAL) YELLOW INSPECTION COPY (INITIAL) PINK OWNER COPY (INITIAL) GOLD

5 6 6 2 0 0