IREDELL COUNTY HEALTH DEPARTMENT STATESVILLE 704-878-5305 MOORESVILLE 704-664-5281

IMPROVEMENT PERMIT / AUTHORIZATION TO CONSTRUCT / OPERATION PERMIT / EXISTING SYSTEM INSPECTION

PERMIT # Repair PIN # 4727-55-3731 DATE 22 January 2010

OWNER or APPLICANT Al Rhyne PHONE: ~~Business~~ cell (704) 881-2027 Home:

OWNER or APPLICANT ADDRESS 2959 Wilkesboro Hwy Statesville, N.C.

LOCATION / DIRECTIONS 115N 3rd House on left past Conchman Loop.

SUBDIVISION BLOCK / SECTION LOT # LOT AREA 0.75Ac. DESIGN FLOW 360g/d L.T.A.R. 0.3/1770

Septic Tank Exist. Gallons: STB Date

Pump Tank Gallons: P T Date

Pump Make Model Serial #

Nitrification Field No Fields 1 No Lines 5 Linear Feet 200

Trench Width 36" Max. Trench Bottom Depth 36" Gravel Depth N/A

☐ New System ☑ Repair ☐ Expansion System Type I II (III) IV V VI

System Description:

Repair System Description: 25% Reduction

Maintenance Agreement Required ☐ YES ☑ NO

☑ GRAVITY ☐ PRESSURE


☑ Residence No. Bedrooms 3 ☐ Business No. Persons ☐ Other No. Employees ☐ Slab ☐ Crawl Space ☐ Basement w/plumbing ☑ Basement w/o plumbing

Water Supply ☑ Private ☐ Public ☐ Community


Comments / Conditions * Keep driveway crossing cover at 30in. minimum. * Prop. lines indicated by owner. * Replace Tee in Tank.

Comments / Conditions Existing bored well - unused for water supply. - Has public water.

INITIAL SITE SKETCH

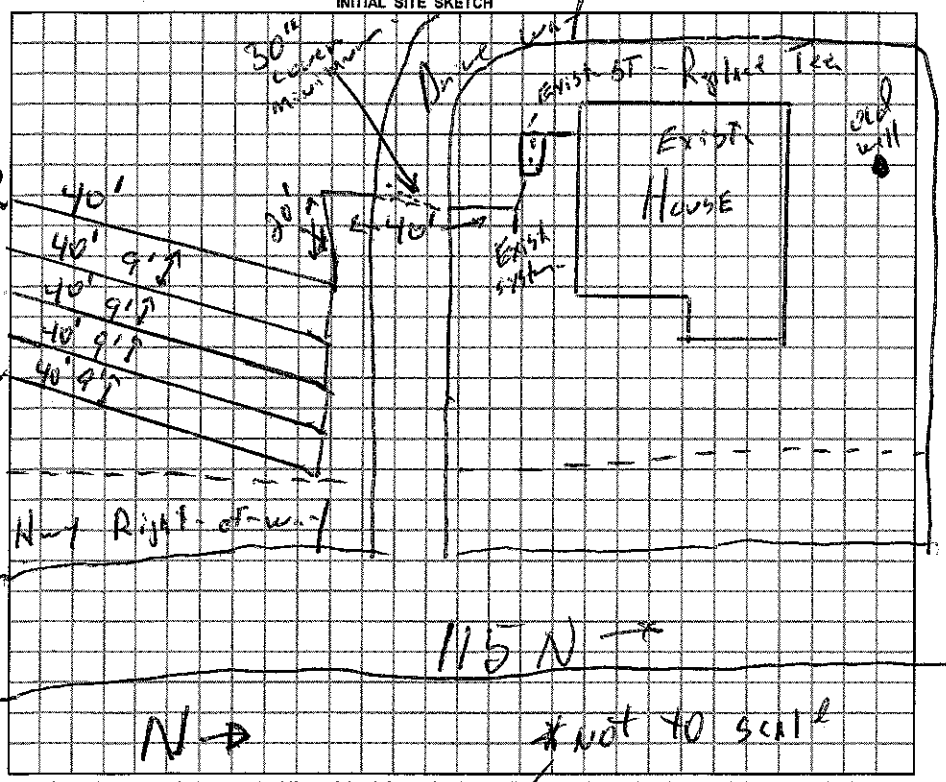

AS BUILT SKETCH

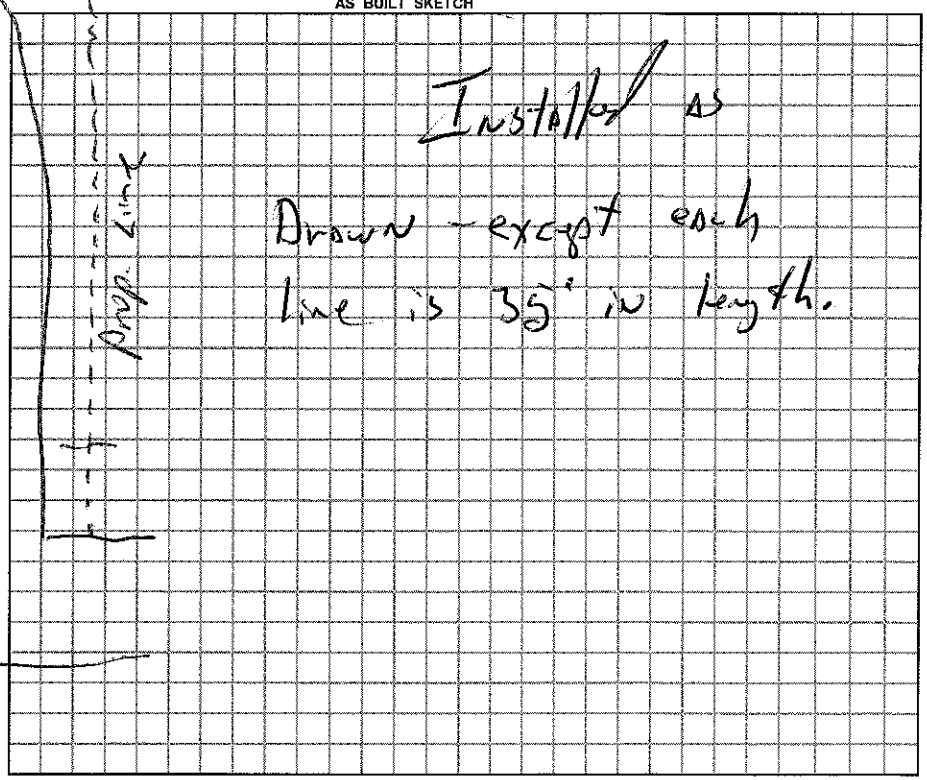

Permit can be suspended or revoked if any false information is supplied toward securing the permit / any unauthorized changes are made to the site / any unauthorized changes are made in the installation of the system.

☐ *IMPROVEMENT PERMIT w / plat valid without expiration.* ☑ *IMPROVEMENT PERMIT w / site plan valid for 60 mos.* ☑ *AUTHORIZATION TO CONSTRUCT valid for period equal to IMPROVEMENT PERMIT-not to exceed 60 mo.*

Owner / Applicant Signature: Date 22 Jan 10

Improvement Permit by: , R.S. Date 22 Jan. 10

Authorzation to Construct by: , R.S. Date 22/Jan.10

Installed by: Kenny Madison

Operation Permit by: , R.S. Date: 26 Jan. 2010

Existing System Inspected by: Date:

YOU SHOULD CONTACT A LOCATOR SERVICE PRIOR TO ANY EXCAVATION.

WHITE COPY Environmental Health YELLOW COPY (Final) Owner / Applicant PINK COPY (Initial) Owner / Applicant