IREDELL COUNTY HEALTH DEPARTMENT

Statesville Phone TR 3-7271 Mooresville Phone No. 664-5281

PERMIT TO INSTALL SEPTIC TANK

Permit No. 4 Permit Date 8-1 1973

Owner Mrs Pearl Gibson (A. Lewis) Eller Address Statesville N.C.

Installed By Herman Gibson Address Statesville NC.


Location of Property Hwy 115 N. House on R. Across road from Trinity Volunteer Fire Dept.

Tank		Capacity		Length of Lines		Fixtures	
Block	( )	1000	(✓)	225'	(✓)	No. of Baths	(1)
Precast	(✓)	1250	( )	250'	( )	Dishwasher	( )
		1500	( )	Other		Garbage Grdr.	( )
		Other				Other	

NOTIFY HEALTH DEPARTMENT AT LEAST EIGHT HOURS BEFORE TANK IS TO BE INSPECTED.

Final Inspection 8-1 1973 Approved (✓) Disapproved ( )

Remarks Well over 100' from system

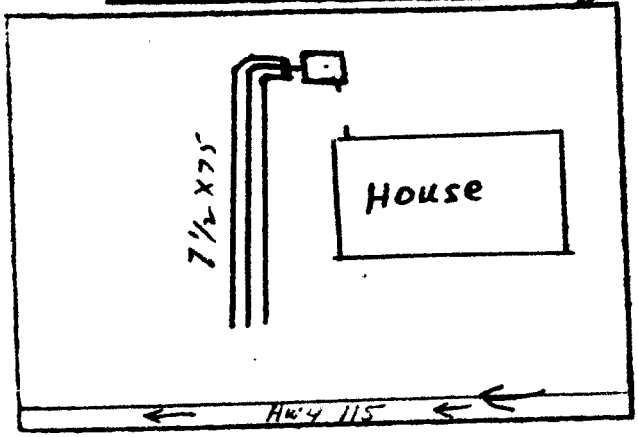

Sketch of Installation

E. A. Stevenson

Sanitarian