# IREDELL COUNTY HEALTH DEPARTMENT

STATESVILLE 704-878-5305 MOORESVILLE 704-664-5281

## IMPROVEMENT PERMIT / CERTIFICATE OF COMPLETION / OPERATION PERMIT / EXISTING SYSTEM INSPECTION

PROPERTY DESCRIPTION NO. 066512 DATE 5-12-97 TAX MAP NO. 4727567832 Watershed: IRBA ID No

OWNER OR CONTRACTOR YADKIN BAPTIST CHURCH PHONE: Business Home KENNETH McCANN 881-6593

ADDRESS 466 YADKIN VALLEY ROAD, STATESVILLE, NC 28677

LOCATION NC 115 N, ON RIGHT AT YADKIN VALLEY ROAD.

SUBDIVISION BLOCK / SECTION LOT LOT AREA 8.5 ACRES SITE CLASS. PS DESIGN FLOW 450 L.T.A.R. 0.30 GPD/FT²

Septic Tank: 1000 Gallons; STB 794 Date 4-4-97

Pump Tank: Gallons; PT Date

Pump Make: Model Serial No.

Nitrification Field: No Fields 1 Square Feet 1500 Linear Feet 500

No Lines FIVE Trench Width 36" Max Trench Bottom Depth 36" Gravel Depth 12

☑ New System ☐ Repair System Type: I, II, III, IV, V, VI

System Description: CONVENTIONAL EBNITM

Repair System Description: CONV. GRAVITY

Maintenance Agreement Required: ☐ Yes ☑ No

☐ House/Mod. Home No. Bedrooms

☐ Mobile Home No. Bathrooms 2

☐ Business No. Employees

☑ Other CHURCH w 232@3 GPD

☐ Slab ☐ Crawl Space ☐ Basement w/plumbing ☐ Basement wo/plumbing


Water Supply: ☐ Individual ☐ Community ☐ Public

Comments: 696 TOTAL GPD, CREDIT GIVEN FOR EXISTING 240 LF SERVING FELLOWSHIP BUILDING (196 SEATS + 36 CHOIR)


Comments:

SCALE: 1"=50'

INITIAL SITE SKETCH

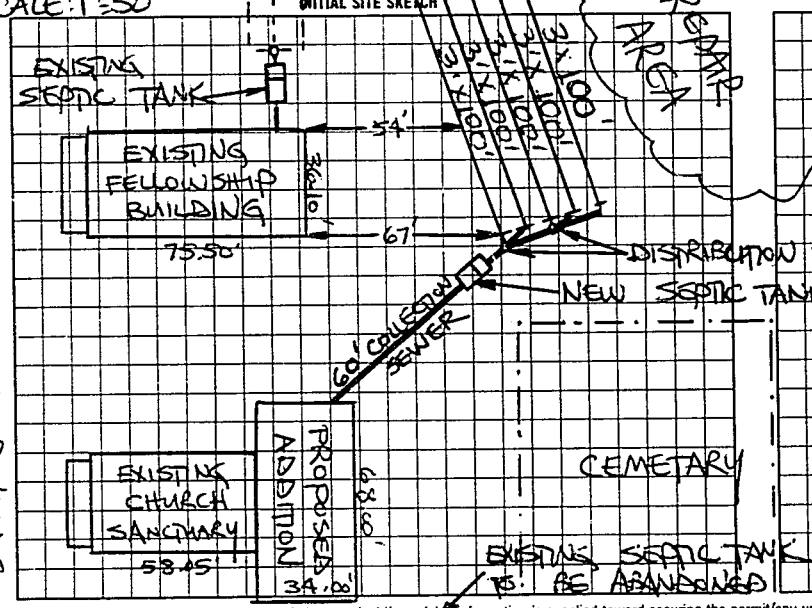


AS BUILT SKETCH

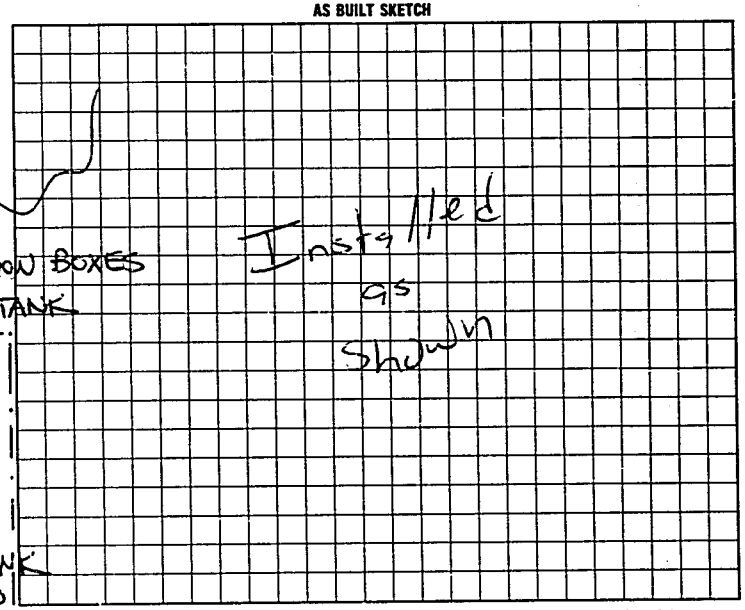


I understand that this permit can be suspended or revoked if any false information is supplied toward securing the permit/any unauthorized changes are made to the site/any unauthorized changes are made in the installation of the system. Improvement Permit is valid for 60 months from date of issuance. AUTHORIZATION TO CONSTRUCT IS VALID FOR 60 MONTHS FROM DATE OF ISSUANCE.

Signed: Kenneth McCann

Improvement Permit by: STEVE HENDRICK date 5-13-97

AUTH. TO CONST ~~Existing System Inspection~~ by STEVE HENDRICK date 5-13-97

Installed by: James Hundley

~~Certificate of Completion by:~~ date

Operation Permit by: [signature] PS date 1-

HEALTH DEPT COPY: WHITE INSPECTION COPY (FINAL): GREEN OWNER COPY (FINAL): YELLOW INSPECTION COPY (INITIAL): PINK OWNER COPY: [illegible]

8 1 3 E 0 0