IREDELL COUNTY HEALTH DEPARTMENT

Statesville Office (704) 878-5305 Mooresville Office (704) 660-3625 PERMIT # 178090

IMPROVEMENT PERMIT / AUTHORIZATION TO CONSTRUCT / OPERATION PERMIT / EXISTING SYSTEM

PIN# 4727573055

APPLICANT: Les Besteers LLC APPLICANT ADDRESS: 792 E. Meadows Rd.

SITE ADDRESS: 3004 Wilkesboro Hwy - Stat. PHONE: 336-262-7485 ALT. PHONE: N/A

SITE DIRECTIONS: Hwy 115 N House on right across from Chucks BBQ


SUBDIVISION: N/A SECTION: N/A LOT # N/A LOT AREA: 0.21 acres DESIGN FLOW: 360gpd L.T.A.R.: 0.3

Septic Tank	Existing	(gal)	STB		Date	☐ New System	☑ Repair	☐ Expansion	System Type: I II III IV V VI	☑ Residence	No. Bedrooms 3
Pump Tank	1000	(gal)	PT	Im-1060	Date [illegible]	System Description:				☐ Business	No. Persons
Pump Make	Goulds	Model	PE 51M		Serial # C1359696	Repair System Description:	Low Pressure PPBPS			☐ Other	No. Employees
# Nitrification Fields	1	# Lines	4		Linear Ft: 128	Maintenance Agreement Required:	☑ YES	☐ NO		☐ Slab	☑ Crawl Space
Trench Width	24"	Max. Trench Bottom Depth	36"		Gravel Depth N/A		☐ GRAVITY	☑ PRESSURE		☐ Basement w/plumbing	☐ Basement w/o plumbing

Water Supply: ☐ Private ☑ Public ☐ Community

Comments / Conditions: Improvements ONLY! Must apply for well abandonment permit from Health Department & have well properly abandoned. Install a low pressure PPBPS system on contour with parallel distribution

INITIAL SITE SKETCH

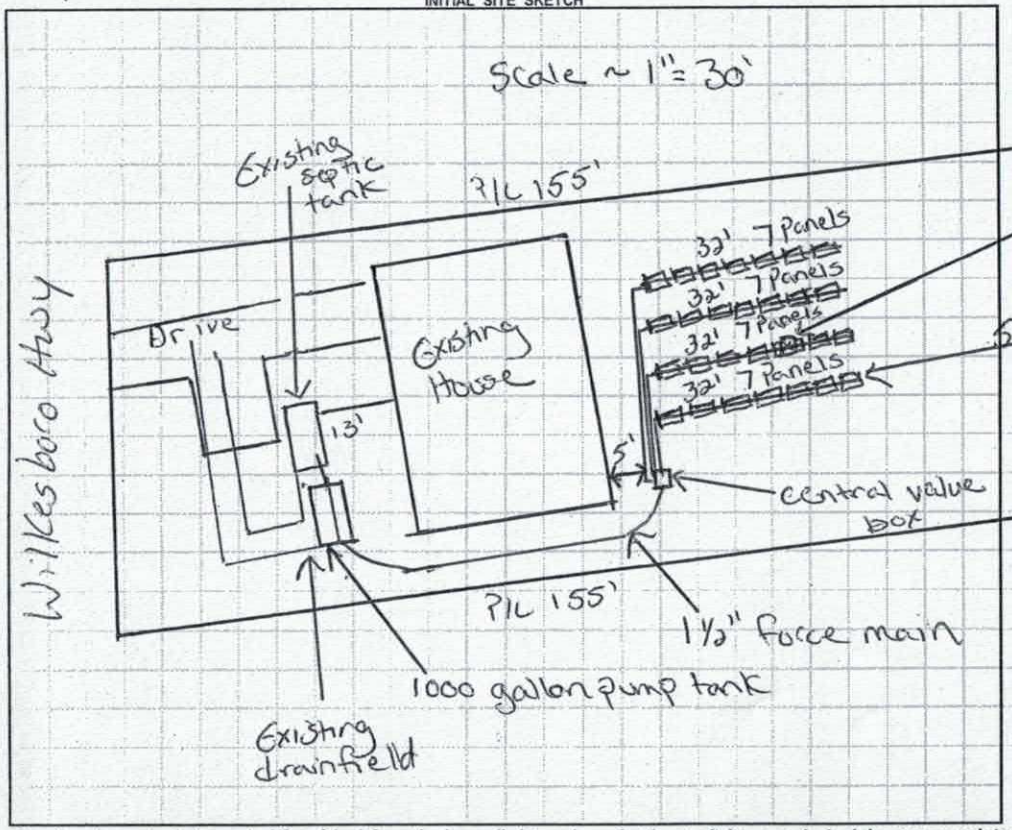

AS BUILT SKETCH

- Aqua Work Panel installed
- Installed as drawn

	Date	Initials
Drain Lines Checked	6-19-13	JH
Tanks Checked	6-19-13	JH
Pressure Manifold or Valve Box Checked	6-20-13	JH
Pressure Head Set	6-20-13	JH
Electrical Checked		
Floats Set	N/A	N/A
Alarm Checked	6-20-13	JH
Maintenance Contract Y / N	Y 6-18-13	JH

Permit can be suspended or revoked if any false information is supplied toward securing the permit / any unauthorized changes are made to the site / any unauthorized changes

☐ **IMPROVEMENT PERMIT** *with plat* valid without expiration. ☑ **IMPROVEMENT PERMIT** *with site plan* valid for 60 mos. ☐ **AUTHORIZATION TO CONSTRUCT** valid for period equal to IMPROVEMENT PERMIT--not to exceed 60 mo.

Owner / Applicant Signature: [signature] Date: 4-11-13 Installed by: Water Management / Sid Gaskins

IMPROVEMENT PERMIT by: Justin Henderson Date: 4-11-13 OPERATION PERMIT by: Date:

AUTHORIZATION TO CONSTRUCT by: Justin Henderson Date: 4-25-13 Existing System Inspected by: Date:

Health Dept. Copy - WHITE Applicant (Final Approval) - YELLOW Applicant (Conditional Approval) - PINK