IREDELL COUNTY HEALTH DEPARTMENT

Statesville Phone TR 3-7271 Mooresville Phone NO 3-1271

PERMIT TO INSTALL SEPTIC TANK

Permit NO. _____ Permit Date May 1 19 67

Owner H. C. Nanty Address 807 N. Mulberry St.

Installed By Stoke & Sons Address R7


Location of Property Twenty Acres S/D 115 N - Right dirt #1957 go 1 blk on Right.

Tank		Capacity		Length of Lines		Fixtures	
Block	( )	1000	( )	225'	( )	No. of Baths	( )
Precast	( )	1250	( )	250'	( )	Dishwasher	( )
Leach		1500	( )	Other _____		Garbage Grdr.	( )
		Other _____				Other _____	

NOTIFY HEALTH DEPARTMENT AT LEAST EIGHT HOURS BEFORE TANK IS TO BE INSPECTED.

Final Inspection _____ 19___ Approved ( ) Disapproved ( )

Remarks Well 75' Red clay soil - Not liable any damage due to grade or landscape work

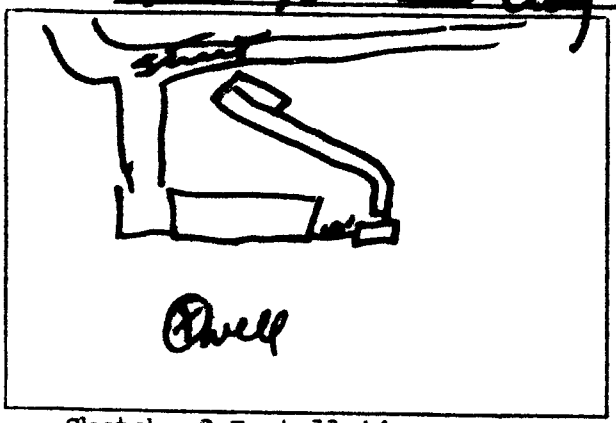

Sketch of Installation

Sanitarian