To Zoning Copy

IREDELL COUNTY HEALTH DEPARTMENT

Statesville Office (704) 878-5305 Mooresville Office (704) 660-3625 PERMIT # 206441 209147

IMPROVEMENT PERMIT / AUTHORIZATION TO CONSTRUCT / OPERATION PERMIT / EXISTING SYSTEM

PIN # 4727588661

APPLICANT: Hayday Investments LLC APPLICANT ADDRESS: 161 West Dodson Mill Rd.

SITE ADDRESS: 143 Branchwood Rd. PHONE: 704-902-2659 ALT. PHONE: N/A

SITE DIRECTIONS: Hwy 115 N TR Branchwood Rd Property on Left.


SUBDIVISION: N/A SECTION: N/A LOT # N/A LOT AREA: 0.96 acres DESIGN FLOW: 480gpd L.T.A.R.: 0.3

Septic Tank	1000 (gal)	STB	760	Date	10-3-14	☑ New System ☐ Repair ☐ Expansion	System Type: I II III IV V VI	☑ Residence	No. Bedrooms	4
Pump Tank	N/A (gal)	PT	N/A	Date	N/A	System Description:	25% Reduction	☐ Business	No. Persons	8
Pump Make	N/A	Model	Poly Vlc	Serial #	PL-68	Repair System Description:	Low Pressure Panels	☐ Other	No. Employees	
# Nitrification Fields	1	# Lines	5	Linear Ft:	400	Maintenance Agreement Required:	☐ YES ☑ NO	☐ Slab	☑ Crawl Space	
Trench Width	36"	Max. Trench Bottom Depth	24"	Gravel Depth	N/A		☑ GRAVITY ☐ PRESSURE	☐ Basement w/plumbing	☐ Basement w/o plumbing	


Water Supply: ☐ Private ☑ Public ☐ Community

Comments / Conditions: Install a 25% Reduction System on contour with serial distribution.
- Do NOT CUT FOR House SITE!!

INITIAL SITE SKETCH

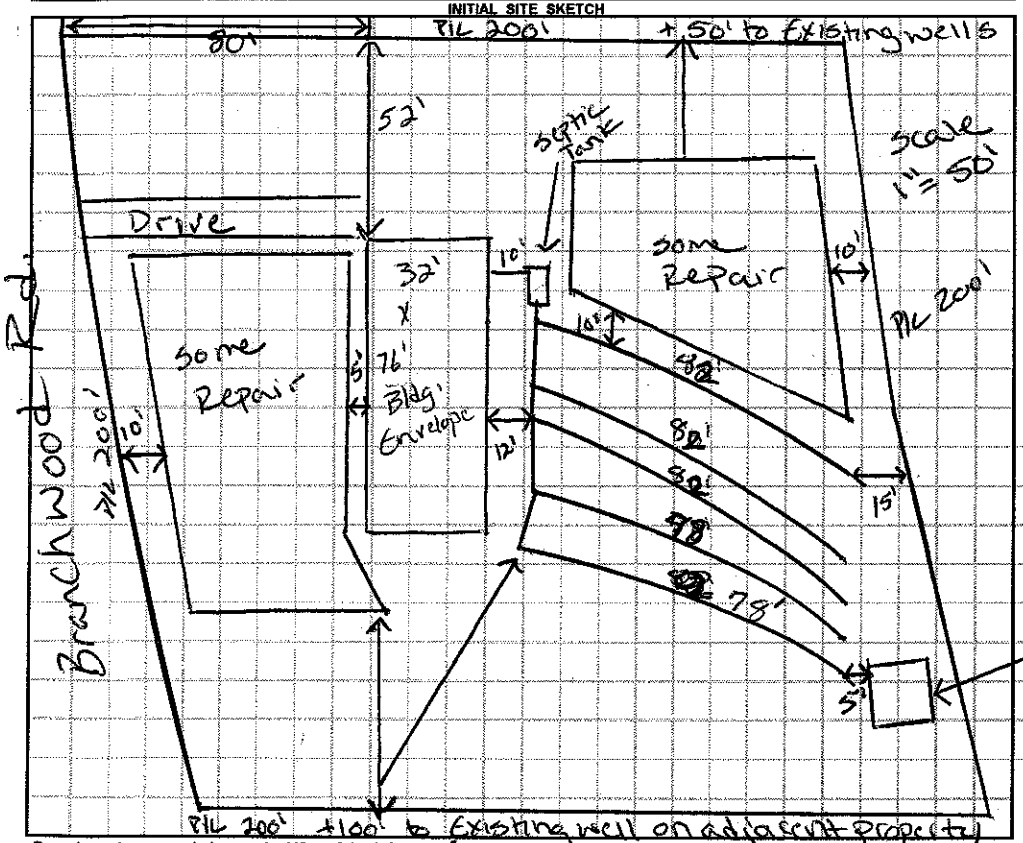

AS BUILT SKETCH

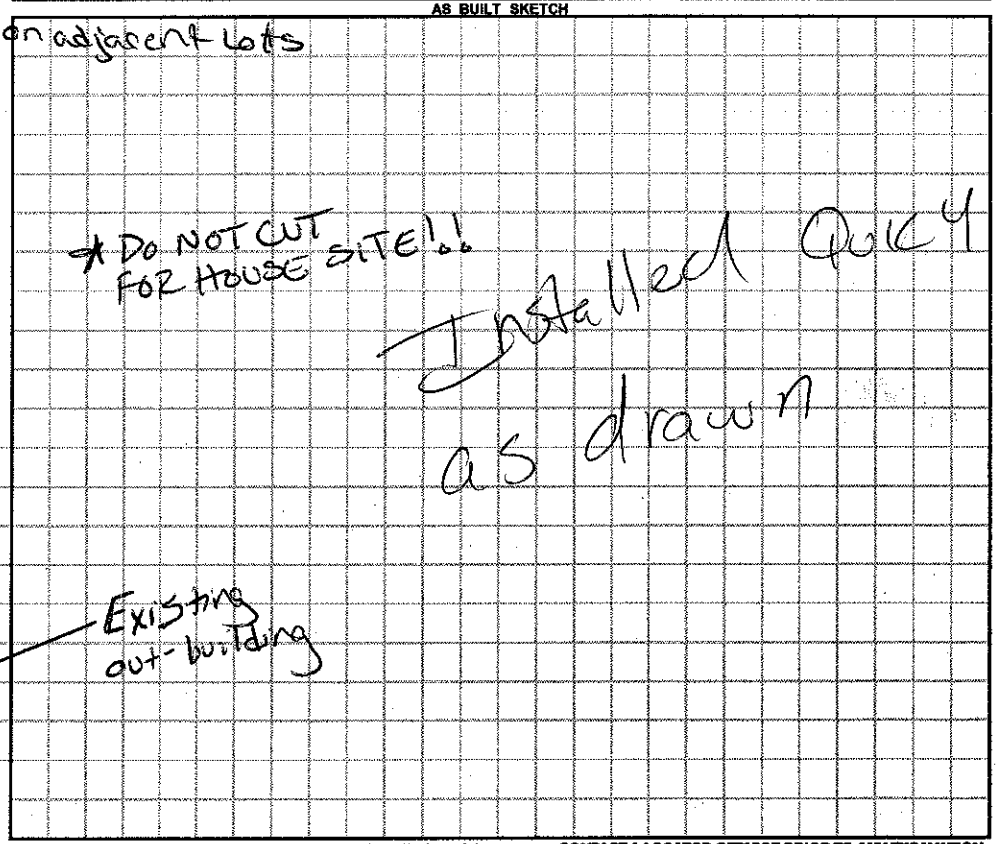

Permit can be suspended or revoked if any false information is supplied toward securing the permit / any unauthorized changes are made to the site / any unauthorized changes are made in the installation of the system. **CONTACT A LOCATOR SERVICE PRIOR TO ANY EXCAVATION**

☐ **IMPROVEMENT PERMIT** *with plat valid without expiration.* ☑ **IMPROVEMENT PERMIT** *with site plan valid for 60 mos.* ☑ **AUTHORIZATION TO CONSTRUCT** *valid for period equal to IMPROVEMENT PERMIT--not to exceed 60 mo.*

Owner / Applicant Signature: (Waived) Date: 11-25-14 Installed by: Steve Bryant

IMPROVEMENT PERMIT by: Justin Henderson Date: 11-12-14 OPERATION PERMIT by: Date: 03/24/15

AUTHORIZATION TO CONSTRUCT by: Justin Henderson Date: 11-12-14 Existing System Inspected by: Date:

Health Dept. Copy - WHITE Applicant (Final Approval) - YELLOW Applicant (Conditional Approval) - PINK