IREDELL COUNTY HEALTH DEPARTMENT

STATESVILLE 704-878-5305 MOORESVILLE 704-664-5281

IMPROVEMENT PERMIT / AUTHORIZATION TO CONSTRUCT / OPERATION PERMIT / EXISTING SYSTEM INSPECTION

PERMIT# 083479 PIN# 4727592962 DATE 8-19-99

OWNER OR CONTRACTOR Jackie Keller PHONE: Business Home 876-2453

ADDRESS 151 Culpepper Rd Statesville

LOCATION 115 N TR Windy Hill TL Culpepper at end on (L)

SUBDIVISION BLOCK / SECTION LOT LOT AREA 2.78 SITE CLASS DESIGN FLOW 360 L.T.A.R.

Septic Tank: 1000 Ex Gallons; STB Date

Pump Tank: Gallons; PT Date

Pump Make: Model Serial No.

Nitrification Field: No Fields Square Feet Linear Feet 9x70'

No Lines bed 3 lines Trench Width Max Trench Bottom Depth Gravel Depth

☐ New System ☐ Repair System Type: I, II, III, IV, V, VI

System Description:

Repair System Description:

Maintenance Agreement Required: ☐ Yes ☐ No

☐ House/Mod. Home ☒ Mobile Home ☐ Business ☐ Other

No. Bedrooms 3 No. Bathrooms 2 No. Employees

☐ Slab ☐ Crawl Space ☐ Basement w/plumbing ☒ Basement wo/plumbing

Water Supply: ☒ Individual ☐ Public ☐ Community

Comments/Conditions:

Comments/Conditions

Existing System Check


Keep Basement 15 ft from system

25 ft away from basement Drain

Need to ensure proper fall from House to tank

INITIAL SITE SKETCH

AS BUILT SKETCH

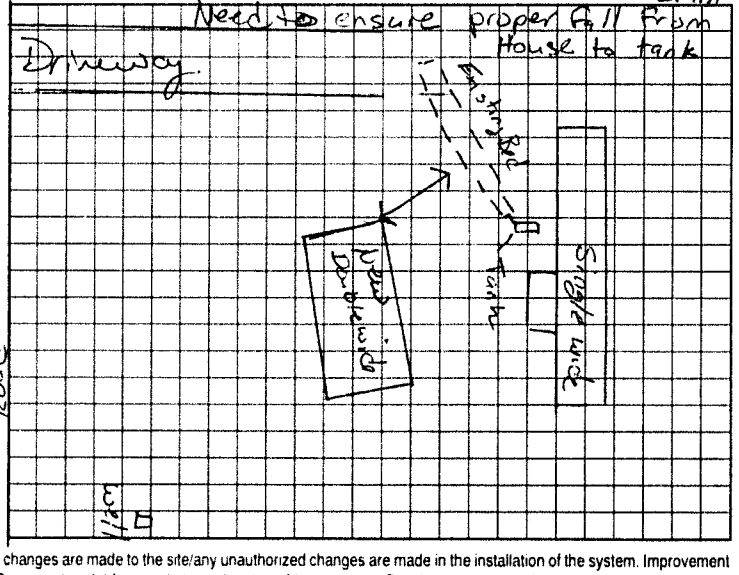

Permit can be suspended or revoked if any false information is supplied toward securing the permit/any unauthorized changes are made to the site/any unauthorized changes are made in the installation of the system. Improvement Permit with plat valid without expiration. Improvement Permit with site plan valid for sixty months. Authorization to Construct is valid for a period equal to that of Improvement Permit – not to exceed sixty months.

Signed: date Installed by

Improvement Permit by: date Operation Permit by date

Authorization to Construct by: date Existing System Inspection by: date 8-19-99

HEALTH DEPT COPY WHITE OWNER COPY (FINAL) YELLOW OWNER COPY (INITIAL) PINK