IREDELL COUNTY HEALTH DEPARTMENT

Statesville Phone TR 3-7271 Mooresville Phone No. 664-5281

PERMIT TO INSTALL SEPTIC TANK

Permit No. 1 Permit Date 3-1 1973

Owner George Mahaffey Sldr Address Statesville NC

Installed By Lackey Bro Address Stony Point N.C.


Location of Property Out 115 Past Gregorys Store T.R. on Rd 1958. Brick house on L in Windy Hill Acres.

Tank		Capacity		Length of Lines		Fixtures	
Block	( )	1000	(✓)	225'	( )	No. of Baths	(2)
Precast	(✓)	1250	( )	250'	( )	Dishwasher	(✓)
		1500	( )	Other 240		Garbage Grdr.	( )
		Other				Other	

NOTIFY HEALTH DEPARTMENT AT LEAST EIGHT HOURS BEFORE TANK IS TO BE INSPECTED.

Final Inspection 3-1 1973 Approved (✓) Disapprcved ( )

Remarks Well 60' from Tank.

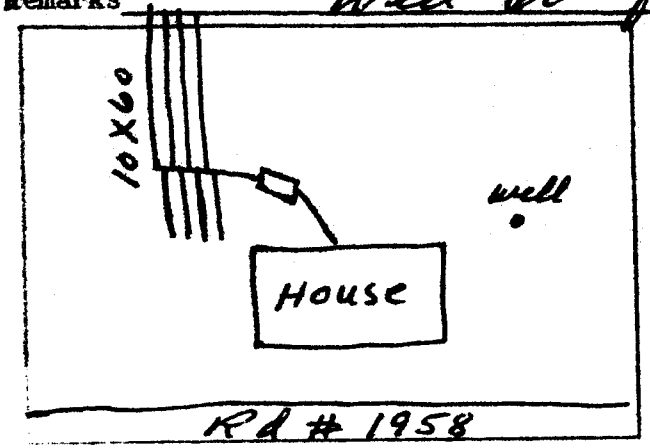

Sketch of Installation

E. A. Stevenson

Sanitarian