IREDELL COUNTY HEALTH DEPARTMENT

STATESVILLE 704-878-5305 MOORESVILLE 704-664-5281

IMPROVEMENT PERMIT / AUTHORIZATION TO CONSTRUCT / OPERATION PERMIT / EXISTING SYSTEM INSPECTION

PERMIT# 070454 PIN# 4727 59 4656 DATE 3-25-98

OWNER OR CONTRACTOR ROMIE A. MARTIN PHONE Business: Home 876-2105

ADDRESS 125 CULPEPPER ROAD, STATESVILLE NC 28625

LOCATION NC 115 N, TR WINDY HILL ROAD, TL CULPEPPER ROAD, MH BEHIND AT HOUSE ON LEFT

SUBDIVISION WINDY HILL BLOCK / SECTION LOT 21 LOT AREA 0.6137 ACRE SITE CLASS. PS DESIGN FLOW 360 L.T.A.R. 0.30 GPD/FT²

Septic Tank: 1000 Gallons; STB Date

Pump Tank: Gallons; PT Date

Pump Make: Model Serial No.

Nitrification Field: No Fields 1 Square Feet 600 Linear Feet 200

No Lines TWO Trench Width 36" Max Trench Bottom Depth 36" Gravel Depth 12"

☑ New System ☐ Repair System Type: I, (II), III, IV, V, VI

System Description: CONVENTIONAL GRAVITY

Repair System Description: CONVENTIONAL PUMP

Maintenance Agreement Required: ☐ Yes ☑ No

☐ House/Mod. Home ☑ Mobile Home ☐ Business ☐ Other

No. Bedrooms 3 No. Bathrooms 2 No. Employees


Water Supply: ☐ Individual ☑ Public ☐ Community

☐ Slab ☑ Crawl Space ☐ Basement w/plumbing ☐ Basement wo/plumbing


Comments:/Conditions: ① INSTALL NEW ~~DROP~~ BOXES FOR SERIAL DISTRIBUTION AT LOCATIONS SHOWN. ② INSTALL TWO NEW 3' x 100' LINES ON CONTOUR AS SHOWN

Comments:/Conditions:

INITIAL SITE SKETCH SCALE: 1"=50'

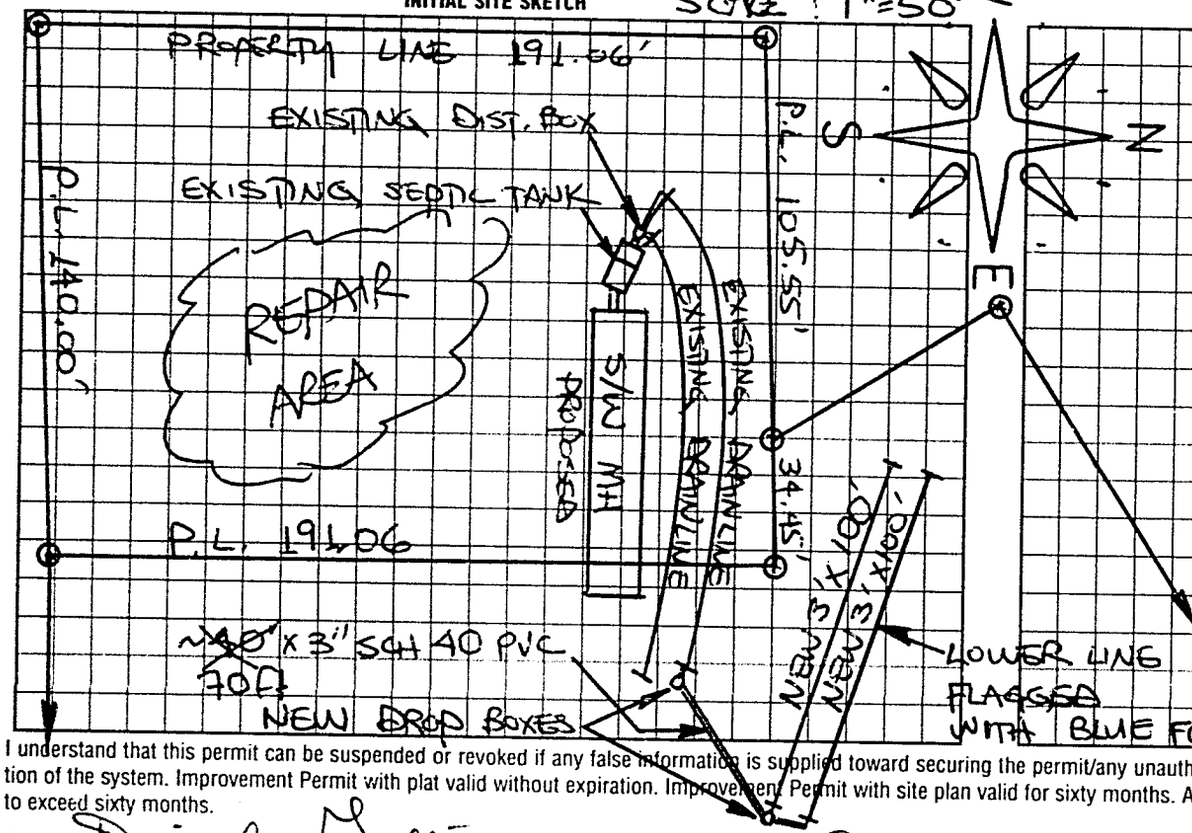

AS BUILT SKETCH

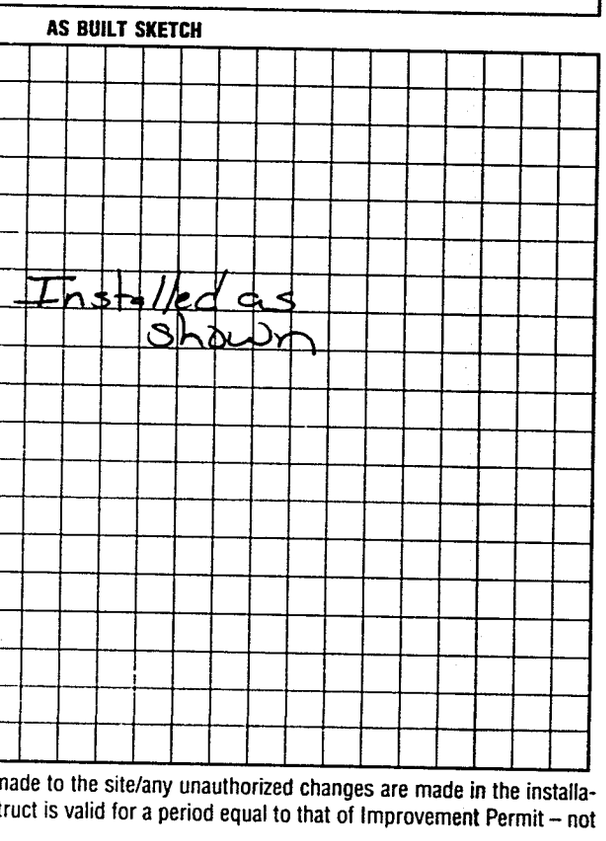

I understand that this permit can be suspended or revoked if any false information is supplied toward securing the permit/any unauthorized changes are made to the site/any unauthorized changes are made in the installation of the system. Improvement Permit with plat valid without expiration. Improvement Permit with site plan valid for sixty months. Authorization to Construct is valid for a period equal to that of Improvement Permit – not to exceed sixty months.

Signed: Derinda Dallimore date 3-25-98 Installed by: Steve Jordan

Improvement Permit by: STEVE HEDRICK date 3-25-98 Operation Permit by: Mark Outlaw date 4-25-98

Authorization to Construct by: STEVE HEDRICK date 3-25-98 Existing System Inspection by: date

HEALTH DEPT. COPY: WHITE INSPECTION COPY (FINAL): GREEN OWNER COPY (FINAL): YELLOW INSPECTION COPY (INITIAL): PINK OWNER COPY (INITIAL): GOLD

1652 U