IREDELL COUNTY HEALTH DEPARTMENT

STATESVILLE 704-878-5305 MOORESVILLE 704-664-5281

IMPROVEMENT PERMIT / AUTHORIZATION TO CONSTRUCT / OPERATION PERMIT / EXISTING SYSTEM INSPECTION

PERMIT# REPAIR PIN# 4727-59-5213 DATE 9-29-04

OWNER OR CONTRACTOR CAROL P. LEVAN PHONE: Business Home 704-876-2543

ADDRESS 115 CULPEPPER ROAD, STATESVILLE, NC 28625

LOCATION NC 115 NORTH TR WINDY HILL ROAD, TL CULPEPPER ROAD, 2ND LOT ON LEFT

SUBDIVISION WINDY HILL BLOCK / SECTION LOT #17 LOT AREA 0.69 ACRE SITE CLASS PS DESIGN FLOW 360 L.T.A.R. EXISTING

Septic Tank: 1000 Gallons; STB 1012 Date 8-10-04
Pump Tank: Gallons; PT Date
Pump Make: Model Serial No.
Nitrification Field: No Fields Square Feet Linear Feet EXISTING
No Lines Trench Width Max Trench Bottom Depth Gravel Depth

☐ New System ☑ Repair System Type: I, II, III, IV, V, VI
System Description:
Repair System Description: CONVENTIONAL, GRAVITY
Maintenance Agreement Required: ☐ Yes ☑ No


☑ House/Mod. Home No. Bedrooms 3
☐ Mobile Home No. Bathrooms 1 1/2
☐ Business No. Employees
☐ Other
☐ Slab ☐ Crawl Space ☐ Basement w/plumbing ☐ Basement wo/plumbing

Water Supply: ☐ Individual ☑ Public ☐ Community

Comments:/Conditions: INSTALL NEW 1000 GALLON SEPTIC TANK WITH RISERS AND FILTER AT LOCATION SHOWN. ABANDON EXISTING SEPTIC TANK BY CRUSHING & FILLING WITH CLAY SOIL.

Comments:/Conditions: SEPTIC TANK WITH RISERS INSTALLED USING "TUFFTITE" FILTER

INITIAL SITE SKETCH

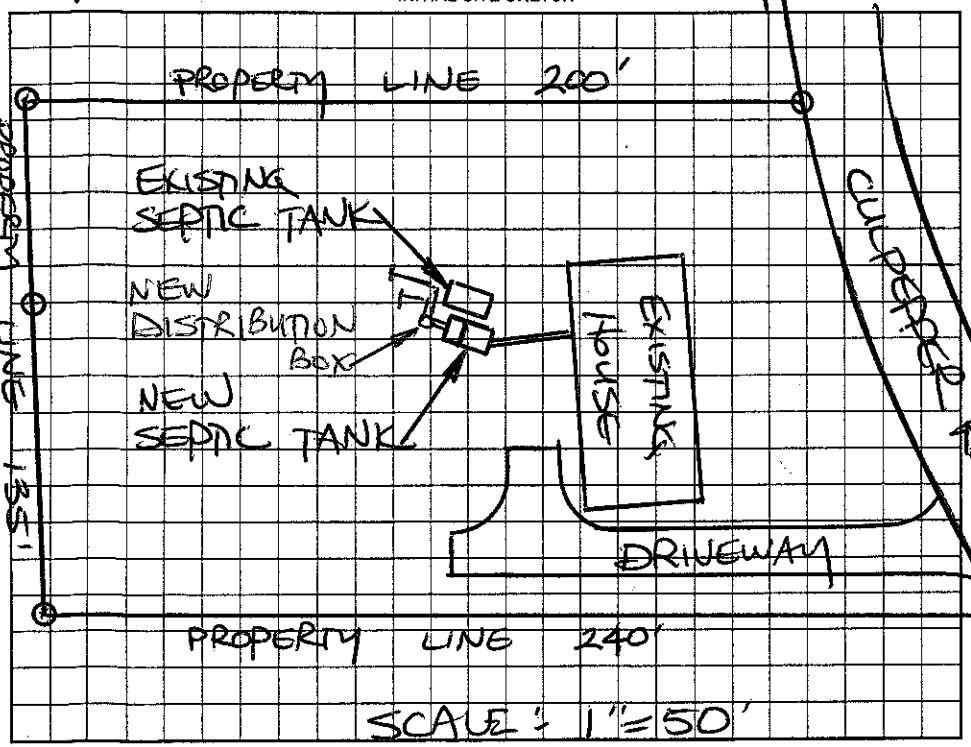

AS BUILT SKETCH

SYSTEM REPAIRED ACCORDING TO INITIAL SITE SKETCH

Permit can be suspended or revoked if any false information is supplied toward securing the permit/any unauthorized changes are made to the site/any unauthorized changes are made in the installation of the system. Improvement Permit with plat valid without expiration. Improvement Permit with site plan valid for sixty months. Authorization to Construct is valid for a period equal to that of Improvement Permit – not to exceed sixty months.

Signed: x Carol Levan date 9-30-04 Installed by: PIEDMONT BACKHOE

Improvement Permit by: STEVE HENDRICK date 9-29-04 Operation Permit by: STEVE HENDRICK date 10-1-04

Authorization to Construct by: STEVE HENDRICK date 9-29-04 Existing System Inspection by: date

HEALTH DEPT. COPY: WHITE OWNER COPY (FINAL): YELLOW OWNER COPY (INITIAL): PINK