IREDELL COUNTY HEALTH DEPARTMENT Not on book

Statesville Phone TR 3-7271 Mooresville Phone NO 3-1271

PERMIT TO INSTALL SEPTIC TANK

Permit No. _____ Permit Date _____ 19__

Owner Doug Harding Address _____

Installed By Hoke Crider Address _____

Location of Property Windy Hill Acres off N. 115


Lot #18, Community Water

Tank		Capacity		Length of Lines		Fixtures	
Block	( )	1000	( )	225'	( )	No. of Baths	(1½
Precast	(✓)	1250	( )	250'	( )	Dishwasher	( )
		1500	( )	Other _____		Garbage Grdr.	( )
		Other _____				Other _____	

NOTIFY HEALTH DEPARTMENT AT LEAST EIGHT HOURS BEFORE TANK IS TO BE INSPECTED.

Final Inspection 7-19-1972 Approved (✓) Disapproved ( )

Remarks This system was installed in Fall of 1970 by Crider who did not have a permit. He uncovered tank for inspection 7-18-72 and if is approved. This came to Health Dept attention after a loan was applied for on home.

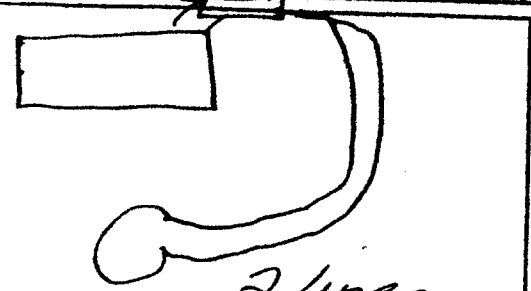

Sketch of Installation

Street

Sanitarian