IREDELL COUNTY HEALTH DEPARTMENT

Statesville Office (704) 878-5305 Mooresville Office (704) 660-3625 PERMIT # 22827

IMPROVEMENT PERMIT / AUTHORIZATION TO CONSTRUCT / OPERATION PERMIT / EXISTING SYSTEM

PIN # 4727595405

APPLICANT: ZIA CONSTRUCTION & REMODELING APPLICANT ADDRESS: 120 MEADOW DRIVE - MOORESVILLE NC 28117

SITE ADDRESS: 125 CULPEPPER DR - STATESVILLE NC PHONE: ALT. PHONE: 704-506-0499

SITE DIRECTIONS: 115 N FROM STATESVILLE - TR WINDY HILL - TL CULPEPPER - ON LT

SUBDIVISION: WINDY HILLS OF ACRES SECTION: LOT # 19 LOT AREA: .47AC DESIGN FLOW: 360 L.T.A.R.: .3

Septic Tank 1000 (gal) STB 825 Date 9/20/16
Pump Tank 1000 (gal) PT 302 Date 8/22/16
Pump Make ZOELLER Model BN152B Serial #
Nitrification Fields 1 # Lines 3 Linear Ft: 201
Trench Width 24" Max. Trench Bottom Depth 36" Gravel Depth N/A

☑ New System ☐ Repair ☐ Expansion System Type: I II III IV V VI
System Description: LP PPBPS
Repair System Description: LP PPBPS
Maintenance Agreement Required: ☑ YES ☐ NO
☐ GRAVITY ☑ PRESSURE

☑ Residence No. Bedrooms 3
☐ Business No. Persons 6
☐ Other No. Employees
☐ Slab ☐ Crawl Space
☑ Basement w/plumbing ☐ Basement w/o plumbing

Water Supply: ☐ Private ☑ Public ☐ Community

Comments / Conditions:

INITIAL SITE SKETCH

See Michael Athanas & Associates Design

AS BUILT SKETCH

Permit can be suspended or revoked if any false information is supplied toward securing the permit / any unauthorized changes are made to the site / any unauthorized changes are made in the installation of the system. **CONTACT A LOCATOR SERVICE PRIOR TO ANY EXCAVATION**

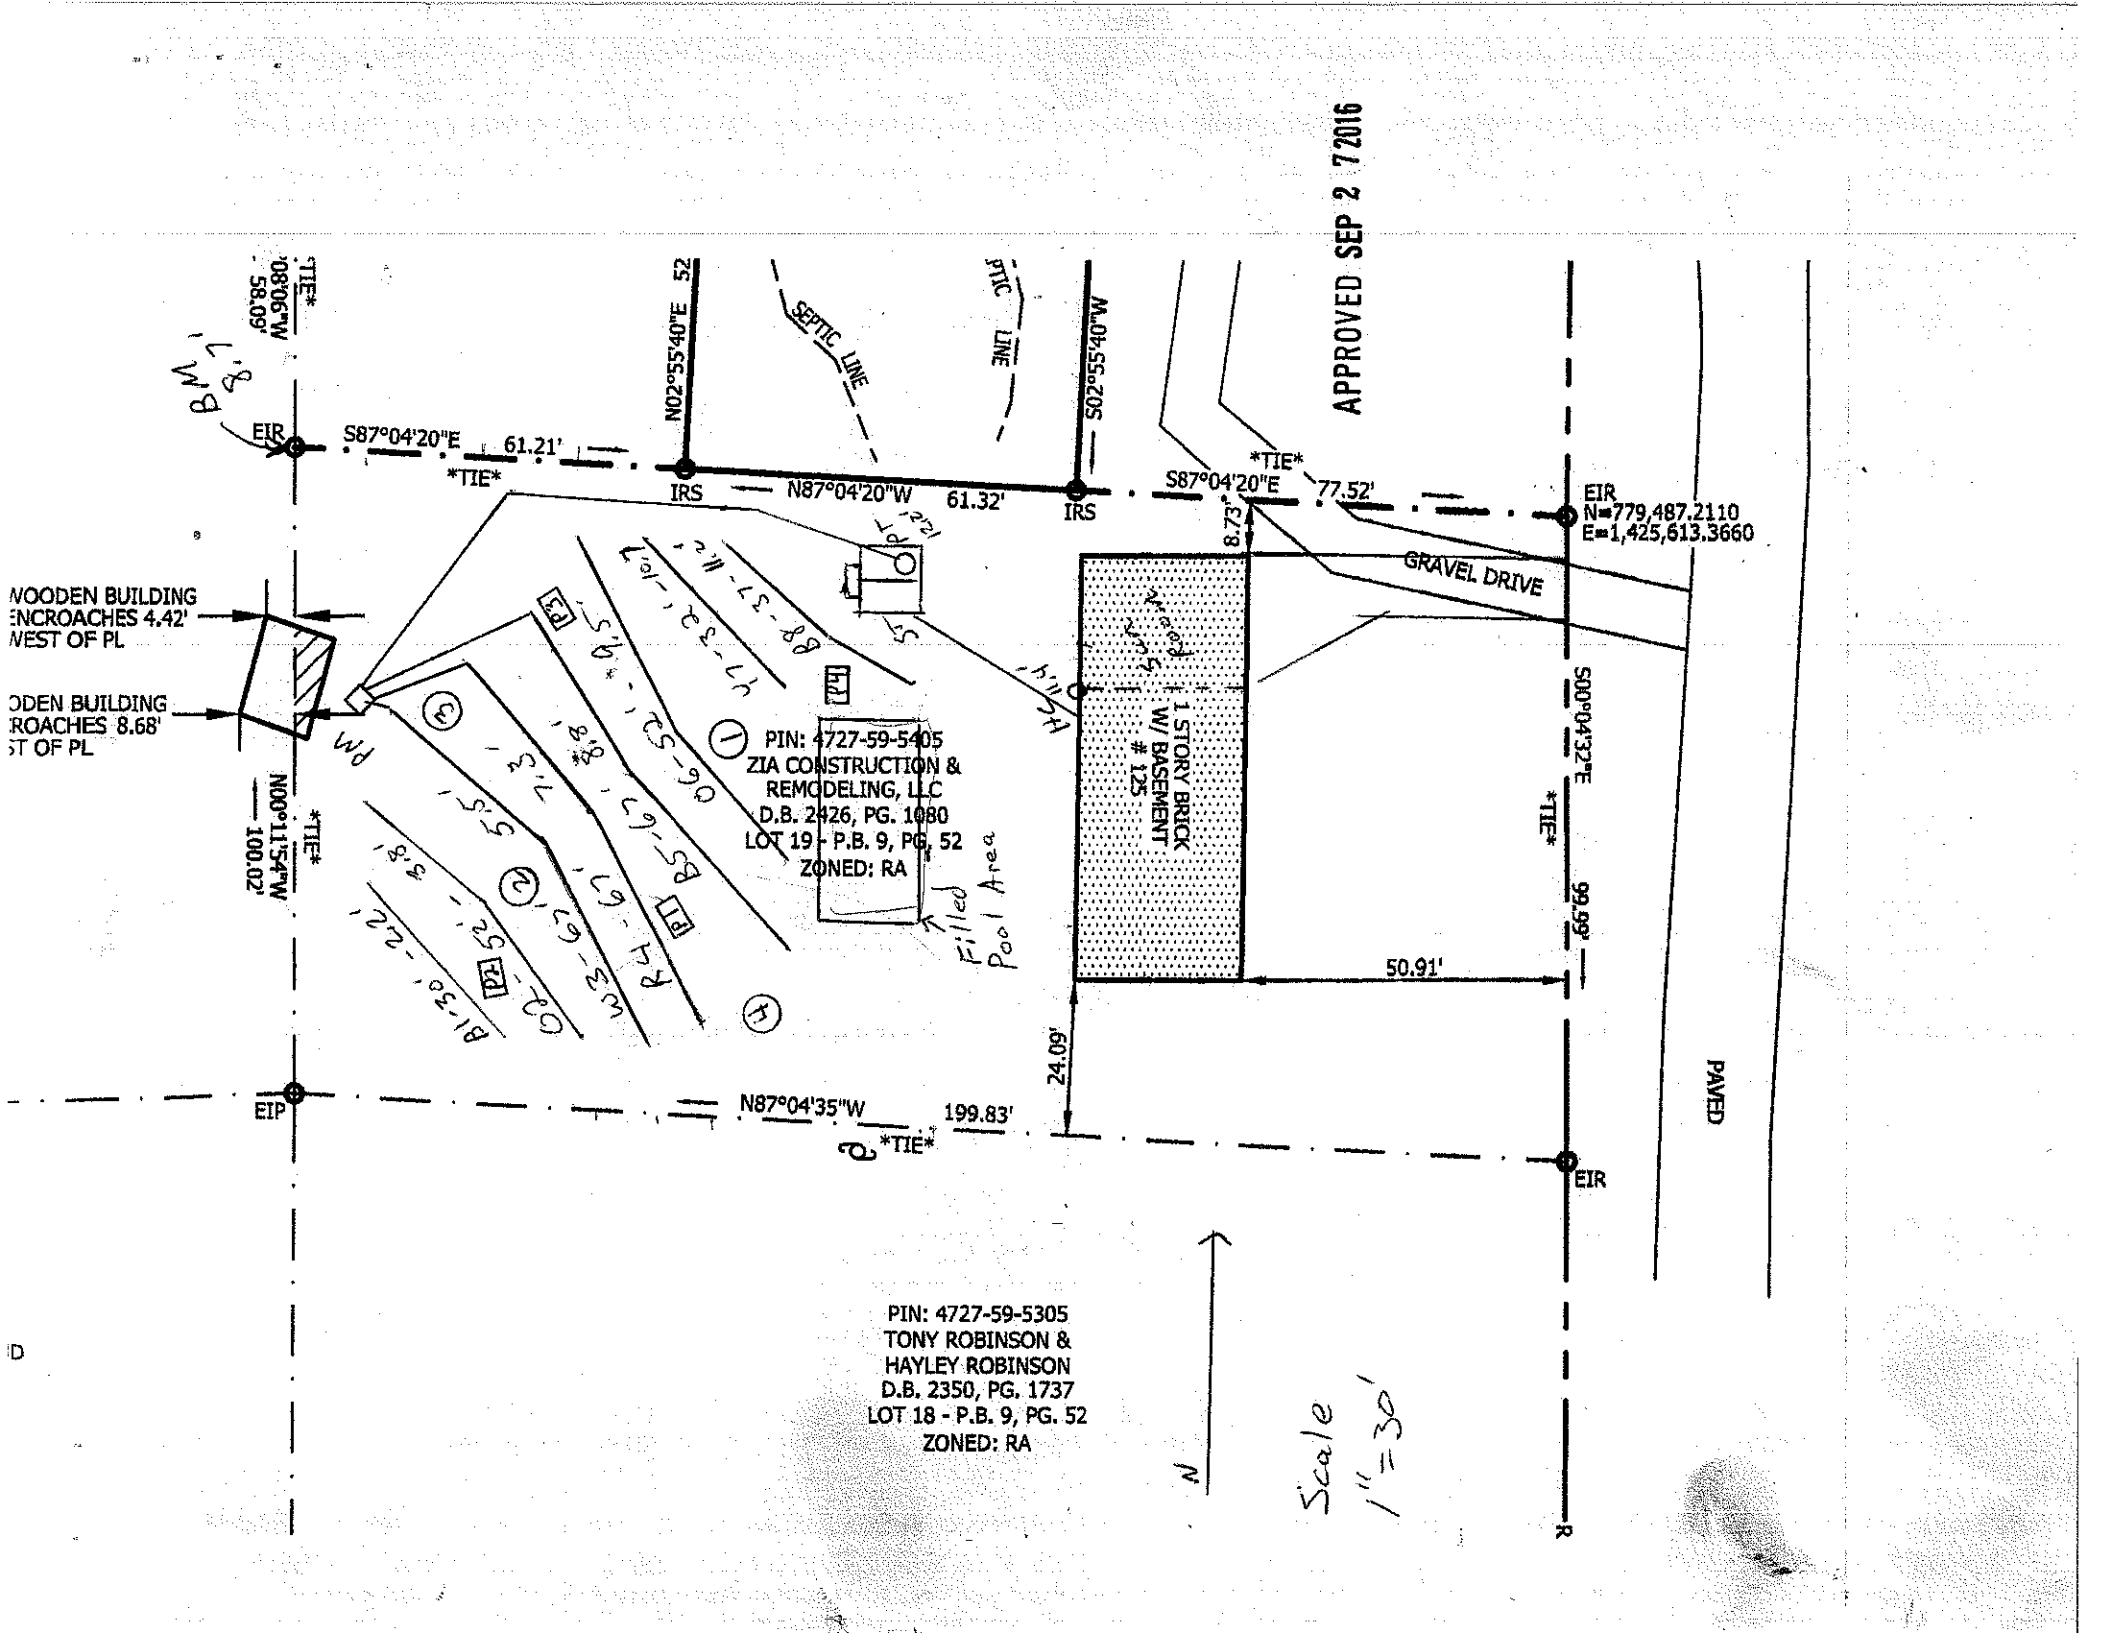
☐ **IMPROVEMENT PERMIT** *with plat valid without expiration.* ☑ **IMPROVEMENT PERMIT** *with site plan valid for 60 mos.* ☒ **AUTHORIZATION TO CONSTRUCT** *valid for period equal to IMPROVEMENT PERMIT--not to exceed 60 mo.*

Owner / Applicant Signature: Date: 11-4-16 Installed by: Rocky Septic Tech

IMPROVEMENT PERMIT by: Date: 9/27/16 OPERATION PERMIT by: Date: 11/9/16

AUTHORIZATION TO CONSTRUCT by: Date: 11/4/16 Existing System Inspected by: Date:

Health Dept. Copy - WHITE Applicant (Final Approval) - YELLOW Applicant (Conditional Approval) - PINK


APPROVED SEP 2 7 2016
EIR
S87°04'20"E 61.21'
TIE
IRS
N87°04'20"W 61.32'
IRS
S87°04'20"E 77.52'
TIE
EIR
N=779,487.2110
E=1,425,613.3660
N02°55'40"E 52
SEPTIC LINE
SEPTIC LINE
S02°55'40"W
8.73'
GRAVEL DRIVE
WOODEN BUILDING
ENCROACHES 4.42'
WEST OF PL
WOODEN BUILDING
ROACHES 8.68'
ST OF PL
N00°11'54"W 100.02'
TIE
PIN: 4727-59-5405
ZIA CONSTRUCTION &
REMODELING, LLC
D.B. 2426, PG. 1080
LOT 19 - P.B. 9, PG. 52
ZONED: RA
Filled Pool Area
1 STORY BRICK W/ BASEMENT # 125
S00°04'32"E
99.99'
TIE
50.91'
24.09'
N87°04'35"W 199.83'
EIP
TIE
EIR
PAVED
PIN: 4727-59-5305
TONY ROBINSON &
HAYLEY ROBINSON
D.B. 2350, PG. 1737
LOT 18 - P.B. 9, PG. 52
ZONED: RA
N
Scale
1" = 30'