IREDELL COUNTY HEALTH DEPARTMENT

Statesville Phone TR 3-7271 Mooresville Phone NO 3-1271

PERMIT TO INSTALL SEPTIC TANK

Permit NO. _____ Permit Date 6-4- 1968

Owner Flake Pratt Bldr. Address city

Installed By C Hoke Address R 7


Location of Property Windy Hill S/D 115 N - past Gregory Store - R - new S/D last on left 2 no block

Tank		Capacity		Length of Lines		Fixtures	
Block	( )	1000	( )	225'	( )	No. of Baths	(2½)
Precast	(+)	1250	( )	250'	( )	Dishwasher	( )
		1500	( )	Other 240		Garbage Grdr.	( )
		Other _____				Other _____	

NOTIFY HEALTH DEPARTMENT AT LEAST EIGHT HOURS BEFORE TANK IS TO BE INSPECTED.

Final Inspection _____ 19__ Approved ( ) Disapproved ( )

Remarks Central well - Sod fall across layout

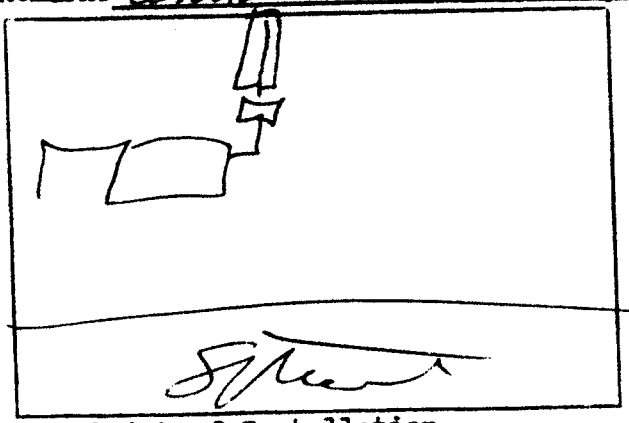

Sketch of Installation

_____

Sanitarian