(B) Postic 9/12/01 ltr

pd#125

IREDELL COUNTY HEALTH DEPARTMENT

STATESVILLE 704-878-5305 MOORESVILLE 704-664-5281

IMPROVEMENT PERMIT / AUTHORIZATION TO CONSTRUCT / OPERATION PERMIT / EXISTING SYSTEM INSPECTION

PERMIT# 100385 PIN# 4727618490 DATE 5/25/01

OWNER OR CONTRACTOR Kenneth McCann PHONE: Business (704) 592-7571 Home —

ADDRESS 317 Curtis Jade Rd Union Grove, N.C. 28689

LOCATION 115 N Over Mallory Lane at End on Left

SUBDIVISION Red Chimney BLOCK / SECTION — LOT # 7 LOT AREA 1.6 SITE CLASS PS DESIGN FLOW 360 L.T.A.R. .3

Septic Tank: 4,000 Gallons: STB 1012 Date 1-20-01
Pump Tank: — Gallons: PT — Date —
Pump Make: — Model — Serial No —
Nitrification Field: No Fields 1 Square Feet 70/200 Linear Feet 300'
No Lines 3 Trench Width 36" Max Trench Bottom Depth 36" Gravel Depth —

[X] New System [ ] Repair System Type: I, II, (III), IV, V, VI
System Description: Gravity, 25% Reduction
Repair System Description: Pump, 50% Reduction
Maintenance Agreement Required: [ ] Yes [X] No

[X] House/Mod. Home No. Bedrooms 3
[ ] Mobile Home No. Bathrooms 2
[ ] Business No. Employees —
[ ] Other —


[ ] Slab [ ] Crawl Space [ ] Basement w/plumbing [X] Basement wo/plumbing

Water Supply: [ ] Individual [X] Public [ ] Community

Comments/Conditions: (1) Install 25% Reduction System using 30 - 10ft HOES Sections or 300' of Chambers (2) Install System on contour (3) Remove Field terrace over Septic System (4) Keep 10ft off PL + 15 from House with Septic lines

Comments/Conditions:
- Poly Lok Filter Installed
- In Filtrator Chambers Installed (50)

INITIAL SITE SKETCH

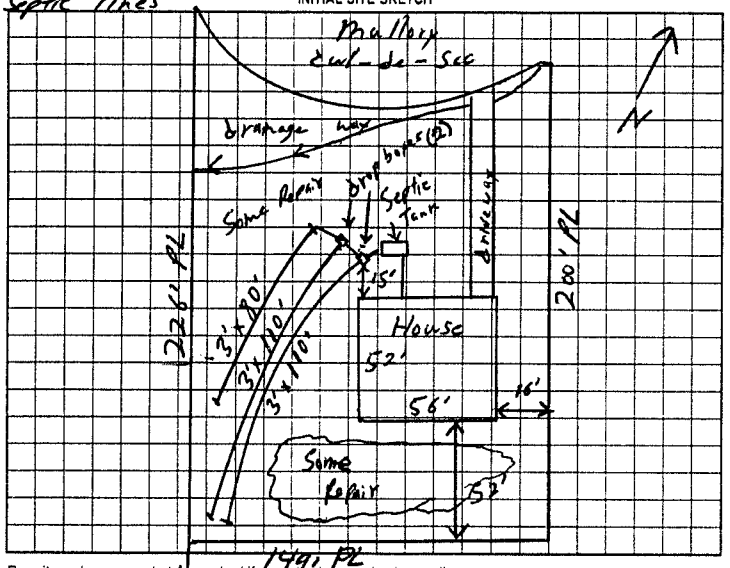

AS BUILT SKETCH

Installed as Shown per Initial Site Sketch

Permit can be suspended or revoked if any false information is supplied toward securing the permit/any unauthorized changes are made to the site/any unauthorized changes are made in the installation of the system. Improvement Permit with plat valid without expiration/Improvement Permit with site plan valid for sixty months. Authorization to Construct is valid for a period equal to that of Improvement Permit – not to exceed sixty months.

Signed: [signature] date 5/25/01 Installed by: Dale Wingler

Improvement Permit by: William O. Johnson date 5/25/01 Operation Permit by: William O. Johnson date 9/11/01

Authorization to Construct by: William O. Johnson date 5/25/01 Existing System Inspection by: — date —

HEALTH DEPT COPY WHITE OWNER COPY (FINAL) YELLOW OWNER COPY (INITIAL) PINK