IREDELL COUNTY HEALTH DEPARTMENT

STATESVILLE 704-878-5305 MOORESVILLE 704-664-5281

IMPROVEMENT PERMIT / AUTHORIZATION TO CONSTRUCT / OPERATION PERMIT / EXISTING SYSTEM INSPECTION

DATE 7-29-00

PERMIT# 090891 PIN# 4727 70 2560 (PT) PHONE: Business 592-7571 Home

OWNER OR CONTRACTOR KENNETH McCANN

ADDRESS 317 SASSY KNOB RD, UNION GROVE NC 28689

LOCATION NC 115 NORTH TL MALLORY CAVE LOT AT END ON RIGHT

SUBDIVISION RED CHIMNEY MEAD BLOCK / SECTION LOT 8 LOT AREA 0.6802 ± AC SITE CLASS PS DESIGN FLOW 240 L.T.A.R. 0.30 SPD/AFT

Septic Tank: 1000 Gallons; STB 1012 Date 8-29-00

Pump Tank: Gallons; PT Date

Pump Make: Model Serial No.

Nitrification Field: No Fields 1 Square Feet 810 Linear Feet 270

No Lines FOUR Trench Width 36" Max Trench Bottom Depth 24" Gravel Depth 12"

☑ New System ☐ Repair System Type: I II III IV V VI

System Description: CONVENTIONAL GRAVITY

Repair System Description: PPBPS - LOW PRESSURE

Maintenance Agreement Required: ☐ Yes ☒ No

☑ House/Mod. Home ☐ Mobile Home ☐ Business ☐ Other

No. Bedrooms 2 No. Bathrooms 2 No. Employees


☐ Slab ☐ Crawl Space ☒ Basement w/plumbing ☐ Basement wo/plumbing

Water Supply: ☐ Individual ☒ Public ☐ Community


Comments/Conditions: ① INSTALL SUBSURFACE INTERCEPT DRAINAGE DITCHES (2) AT LOCATIONS SHOWN BEGINNING 36" DEEP OUT TO DAYLIGHT. ② BASEMENT EXCAVATION NOT TO EXCEED DEPTH OF NATURAL GRADE AT LOWEST CORNER (House)

Comments/Conditions ① SYSTEM SIZED FOR TWO-BEDROOM ONLY ② SEPTIC TANK W/ RISERS INSTALLED USING "POLYLOK" FILTER

INITIAL SITE SKETCH SCALE: 1"=40'

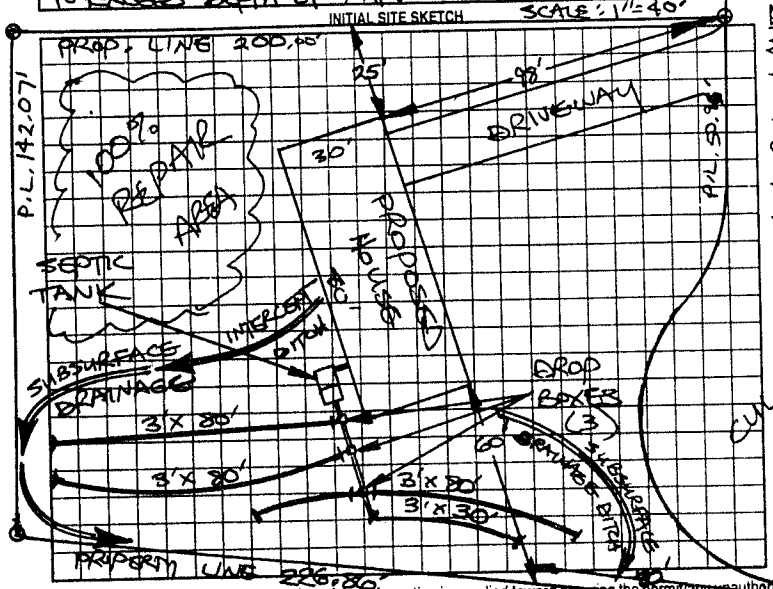

AS BUILT SKETCH

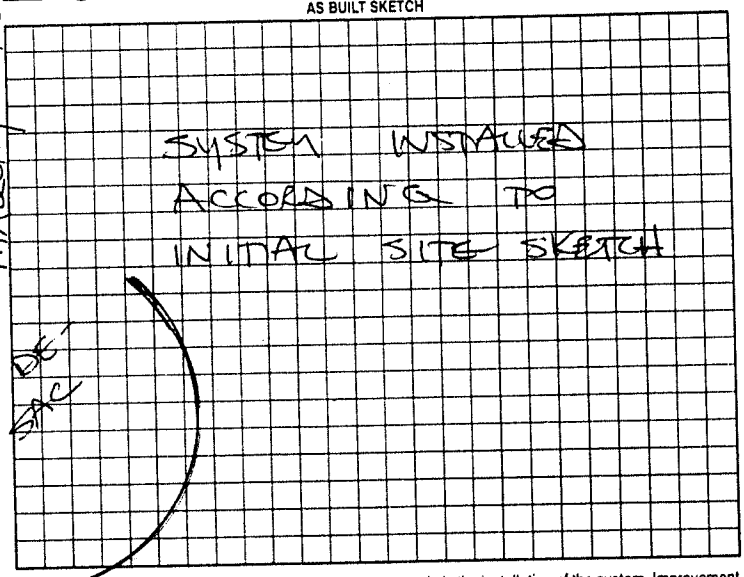

Permit can be suspended or revoked if any false information is supplied toward securing the permit/any unauthorized changes are made to the site/any unauthorized changes are made in the installation of the system. Improvement Permit with plat valid without expiration. Improvement Permit with site plan valid for sixty months. Authorization to Construct is valid for a period equal to that of Improvement Permit – not to exceed sixty months.

Signed: [signature] date 8-2-00

Improvement Permit by: STEVE HEDRICK date 7-29-00

Authorization to Construct by: STEVE HEDRICK date 7-29-00

Installed by: DALE WINGLER

Operation Permit by: STEVE HEDRICK date 10-30-00

Existing System Inspection by: date

HEALTH DEPT COPY WHITE OWNER COPY (FINAL) YELLOW OWNER COPY (INITIAL) PINK