IREDELL COUNTY HEALTH DEPARTMENT

STATESVILLE 704-878-5305 MOORESVILLE 704-664-5281

IMPROVEMENT PERMIT / AUTHORIZATION TO CONSTRUCT / OPERATION PERMIT / EXISTING SYSTEM INSPECTION

PERMIT# 086015 PIN# 4727660984 (PT) DATE 1-10-00

OWNER OR CONTRACTOR JASON SPRINKLE PHONE: Business Home 876-1139

ADDRESS 139 YADKIN VALLEY ROAD, STATESVILLE, NC 28625

LOCATION NC 115 N, TR YADKIN VALLEY ROAD, 0.1 MILE ON LEFT BEHIND BOX # 139

SUBDIVISION BLOCK / SECTION LOT LOT AREA ~200' X 250' SITE CLASS PS DESIGN FLOW 360 L.T.A.R. 0.30 GPD/FT²

Septic Tank: 1000 Gallons; STB 1007 Date 12-7-99

Pump Tank: Gallons; PT Date

Pump Make: Model Serial No.

Nitrification Field: No Fields 1 Square Feet 1200 Linear Feet 400

No Lines FOUR Trench Width 36" Max Trench Bottom Depth 30"

☑ New System ☐ Repair System Type: I (II) III, IV, V, VI

System Description: CONVENTIONAL GRAVITY

Repair System Description: CONV. GRAVITY

Maintenance Agreement Required: ☐ Yes ☑ No

Gravel Depth 12" ☐ Slab ☑ Crawl Space ☐ Basement w/plumbing ☐ Basement wo/plumbing

☐ House/Mod. Home No. Bedrooms 3

☑ Mobile Home No. Bathrooms 2½

☐ Business No. Employees

☐ Other


Water Supply: ☑ Individual ☐ Public ☐ Community

WELL

Comments/Conditions: ① INSTALL SUBSURFACE INTERCEPT DRAINAGE DITCH AT LOCATION SHOWN BEGINNING 42" DEEP OUT TO DAYLIGHT ② GRADE SITE TO IMPROVE DRAINAGE OF SURFACE WATER AWAY FROM SYSTEM

Comments/Conditions: SEPTIC TANK WITH MARKER INSTALLED USING "ZABEL" FILTER

INITIAL SITE SKETCH SCALE: 1"=50'

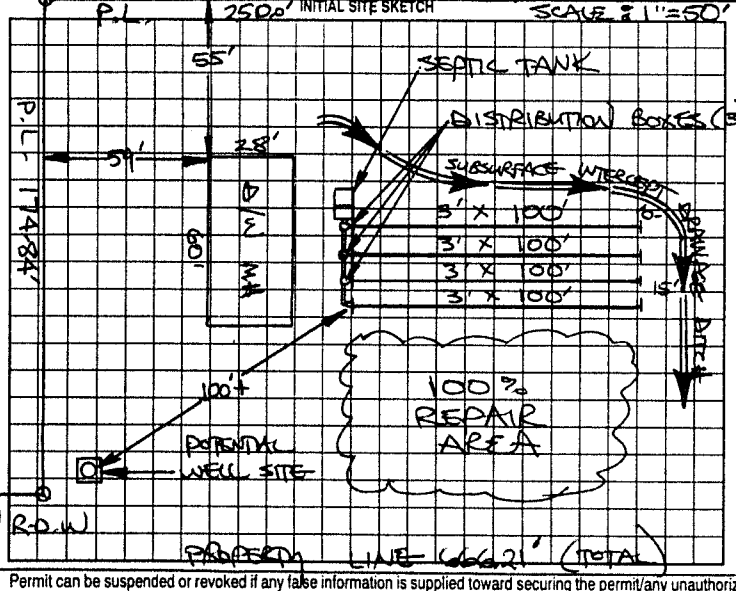

AS BUILT SKETCH

SYSTEM INSTALLED ACCORDING TO INITIAL SITE SKETCH

Permit can be suspended or revoked if any false information is supplied toward securing the permit/any unauthorized changes are made to the site/any unauthorized changes are made in the installation of the system. Improvement Permit with plat valid without expiration. Improvement Permit with site plan valid for sixty months. Authorization to Construct is valid for a period equal to that of Improvement Permit – not to exceed sixty months.

Signed: [signature] date 1-10-00

Improvement Permit by: STEVE HEDRICK date 1-10-00

Authorization to Construct by: STEVE HEDRICK date 1-10-00

Installed by: JAMES HUDLER

Operation Permit by: STEVE HEDRICK date 2-29-00

Existing System Inspection by: date

HEALTH DEPT. COPY: WHITE OWNER COPY (FINAL): YELLOW OWNER COPY (INITIAL): PINK