IREDELL COUNTY HEALTH DEPARTMENT

Statesville Phone TR 3-7271 Mooresville Phone NO 3-1271

PERMIT TO INSTALL SEPTIC TANK

Permit NO. 207 Permit Date JUNE 19 1970

Owner FLAKE PRATT Address STATESVILLE, NC

Installed By Adams Septic Tank Service Address TAYLORSVILLE, NC


Location of Property HIGHWAY 115 NORTH, TURN RIGHT ON ROAD # 1957. RIGHT ON 1ST DIRT STREET, BRICK HOUSE ON RIGHT AT END OF STREET.

Tank		Capacity		Length of Lines		Fixtures	
Block	( )	1000	(✓)	225'	(✓)	No. of Baths	(1)
Precast	(–)	1250	( )	250'	( )	Dishwasher	( )
		1500	( )	Other		Garbage Grdr.	( )
		Other				Other	

NOTIFY HEALTH DEPARTMENT AT LEAST EIGHT HOURS BEFORE TANK IS TO BE INSPECTED.

Final Inspection JUNE 19 1970 Approved (✓) Disapproved ( )

Remarks Well 60' from nitrification field

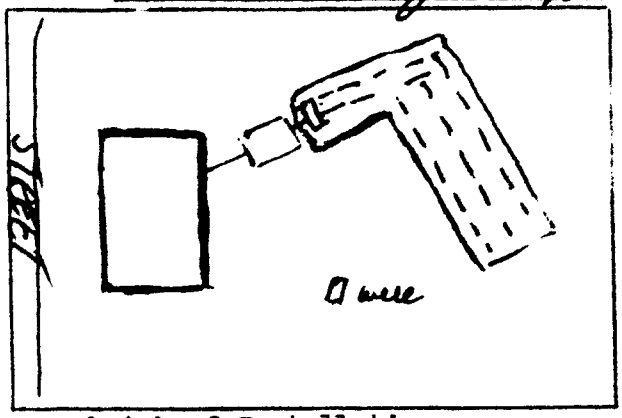

Sketch of Installation

Glenn Taylor

Sanitarian