IREDELL COUNTY HEALTH DEPARTMENT

Statesville Phone TR 3-7271 Mooresville Phone NO 3-1271

PERMIT TO INSTALL SEPTIC TANK

Permit No. 132 Permit Date _____ 19___

Owner Ralph Pollock Address Rt 5 Statesville

Installed By Harlee Lackey Address Stoney Point


Location of Property out #115 N just beyond Gregorys Store T.R. on Road #1908 Trailer on R.

Tank		Capacity		Length of Lines		Fixtures	
Block	( )	1000	(✓)	225'	(✓)	No. of Baths	(/)
Precast	(✓)	1250	( )	250'	( )	Dishwasher	( )
		1500	( )	Other _____		Garbage Grdr.	( )
		Other _____				Other _____	

NOTIFY HEALTH DEPARTMENT AT LEAST EIGHT HOURS BEFORE TANK IS TO BE INSPECTED.

Final Inspection 3-10 1972 Approved (✓) Disapproved ( )

Remarks _____

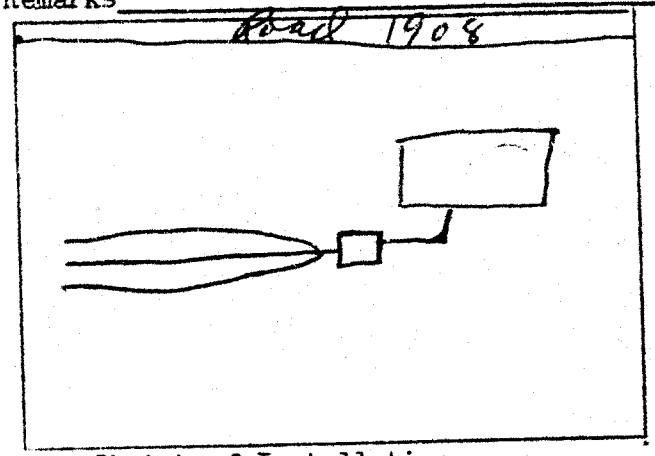

Sketch of Installation

E. A. Stevenson

Sanitarian