IREDELL COUNTY HEALTH DEPARTMENT

STATESVILLE 704-878-5305 CI MOORESVILLE 704-664-5281

IMPROVEMENT PERMIT / AUTHORIZATION TO CONSTRUCT / OPERATION PERMIT / EXISTING SYSTEM INSPECTION

PERMIT# 15767 PIN# 4737-71-~~2170.000~~ 0674 DATE 10-1-03

OWNER OR CONTRACTOR HENDRICK BUILDERS PHONE: Business 704-902-0574 Home

ADDRESS 346 NEW STERLING RD STONY PT, NC 28678

LOCATION 40 WEST, (R) 115, (L) MALLORY LANE, AT END OF PT BY CUL-DE-SAC LOT

SUBDIVISION RED CHIMNEY MEADOWS BLOCK / SECTION ____ LOT 9 LOT AREA .59AC SITE CLASS. PS DESIGN FLOW 360 L.T.A.R. .25

Septic Tank: 1000 Gallons; STB 312 Date 9-3-03
Pump Tank: ____ Gallons; PT ____ Date ____
Pump Make: ____ Model ____ Serial No. ____
Nitrification Field: No Fields 1 Square Feet EA = 1440' Linear Feet 360
No Lines 3 Trench Width 36" Max Trench Bottom Depth 36"

☒ New System ☐ Repair System Type: I, II, (III), IV, V, VI
System Description: GRAY 25% REDUCT
Repair System Description: LP PANEL
Maintenance Agreement Required: ☐ Yes ☒ No
Gravel Depth N/A ☐ Slab ☒ Crawl Space ☐ Basement w/plumbing ☐ Basement wo/plumbing


☒ House/Mod. Home No. Bedrooms 3
☐ Mobile Home No. Bathrooms 2
☐ Business No. Employees ____
☐ Other ____

Water Supply: ☐ Individual ☒ Public ☐ Community

Comments:/Conditions: (1) SYSTEM & HOUSE ARE FLAGGED OUT COMPLETELY (2) MAINTAIN SETBACKS (3) INSTALL LINES ON CONTOURS

Comments:/Conditions:
- 20ml Fifty + ST Marker Installed
- 1ST + 2nd Line OKay BILL JOHNSON

INITIAL SITE SKETCH

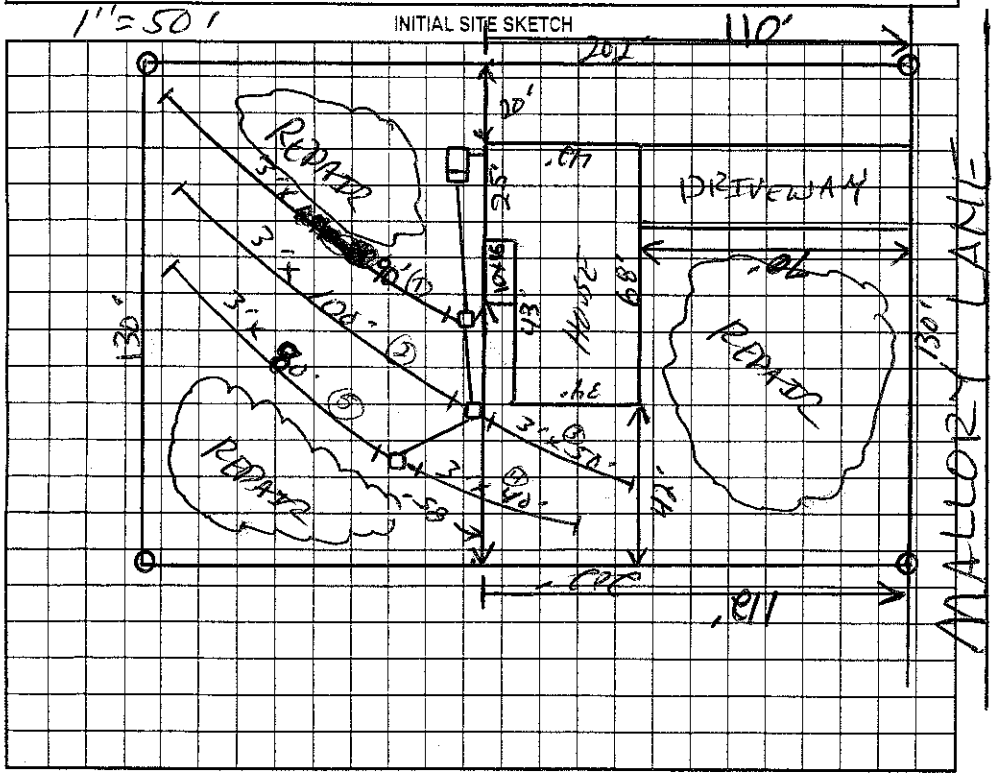

AS BUILT SKETCH

X LINE = 3 = 3½ FALL = TOO DOWN / FIX IT
X LINE = 4 = 2½ FALL = TOO DOWN / FIX IT
✓ LINE = 5 = 2" FALL IN 80' = ALLOWABLE BY ¼/10' FALL RULE
LORNE 12-29-03

LINE 3 = 3¼ FALL ALLOWED IN 50'
LINE 4 = 4 LEVER ALLOWED 12-30-03

SYSTEM W'D OK SPEED LEVELER IN LAST BOX TO FEED 40' LINE FIRST BY 80' LINE. LC 12-30-03

Permit can be suspended or revoked if any false information is supplied toward securing the permit/any unauthorized changes are made to the site/any unauthorized changes are made in the installation of the system. Improvement Permit with plat valid without expiration. Improvement Permit with site plan valid for sixty months. Authorization to Construct is valid for a period equal to that of Improvement Permit -- not to exceed sixty months.

Signed: Martin Hendrick date 10-3-03
Improvement Permit by: ____ date 10-1-03
Authorization to Construct by: ____ date 10-1-03

Installed by: Esker Eldridge
Operation Permit by: ____ date 12-30-03
Existing System Inspection by: ____ date ____

HEALTH DEPT. COPY: WHITE OWNER COPY (FINAL): YELLOW OWNER COPY (INITIAL): PINK