IREDELL COUNTY HEALTH DEPARTMENT

STATESVILLE 704-878-5305 130.00 Pd. MOORESVILLE 704-664-5281

IMPROVEMENT PERMIT / AUTHORIZATION TO CONSTRUCT / OPERATION PERMIT / EXISTING SYSTEM INSPECTION

PERMIT# 118626 PIN# 4727-71-1359 DATE 2-18-05

OWNER OR CONTRACTOR MCKINNEY CONSTRUCTION PHONE: Business (704) 929-9602 Home

ADDRESS 802 WEST END AVE STATESVILLE NC 28677

LOCATION HWY 115 N TL MALLORY LN 5TH LOT ON LEFT

SUBDIVISION REDCHIMNEY MEADOWS BLOCK / SECTION LOT 5 LOT AREA 0.578 SITE CLASS PS DESIGN FLOW 360 L.T.A.R. 0.30 gpd/ft²

Septic Tank: 1000 Gallons; STB 1012 Date 3-19-06
Pump Tank: Gallons; PT Date
Pump Make: Model Serial No.
Nitrification Field: No Fields 1 Square Feet 1200 Linear Feet 200
No Lines 4 Trench Width 24" Max Trench Bottom Depth 36" Gravel Depth 24" SAND

☑ New System ☐ Repair System Type: I, II, (III), IV, V, VI
System Description: GRAVITY PANEL 50% REDUCTION
Repair System Description: LP PANEL 50% REDUCTION
Maintenance Agreement Required: ☐ Yes ☑ No

☑ House/Mod. Home No. Bedrooms 3
☐ Mobile Home No. Bathrooms
☐ Business No. Employees
☐ Other


Water Supply: ☑ Individual ☑ Public ☐ Community

☐ Slab ☑ Crawl Space ☐ Basement w/plumbing ☐ Basement wo/plumbing

Comments/Conditions: ① INSTALL TOTAL 44 PANELS ON CONTOUR ② RAKE & LIME TRENCH WALLS ③ MAINTAIN SETBACKS ④ USE APPROVED SEALANT ⑤ CALL W/ QUESTIONS

Comments/Conditions: SEPTIC TANK WITH MARKER USED WITH TUFTITE FILTER

INITIAL SITE SKETCH ✕ 1" = 40'

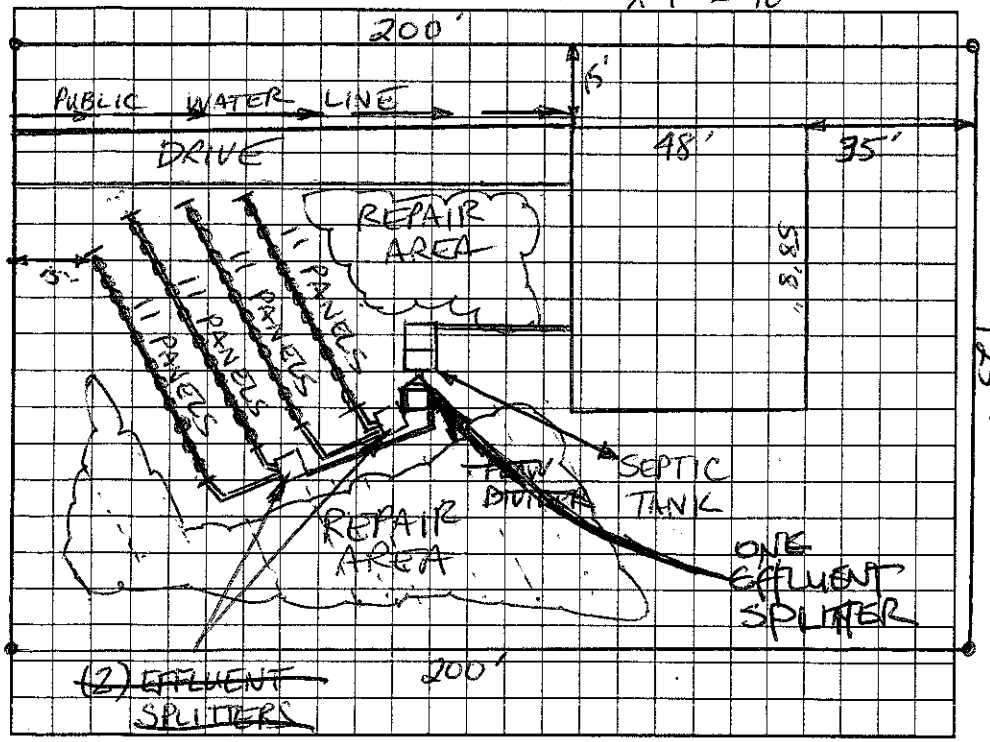

AS BUILT SKETCH

SYSTEM INSTALLED AS SHOWN

Permit can be suspended or revoked if any false information is supplied toward securing the permit/any unauthorized changes are made to the site/any unauthorized changes are made in the installation of the system. Improvement Permit with plat valid without expiration. Improvement Permit with site plan valid for sixty months. Authorization to Construct is valid for a period equal to that of Improvement Permit – not to exceed sixty months.

Signed: Derek McCoy date 4-12-05 Installed by: CRAIG THOMPSON

Improvement Permit by: Christopher M Shirell RS, CSS date 2-18-05 Operation Permit by: STEVE HEDRICK date 7-27-06

Authorization to Construct by: Christopher M Shirell RS, CSS date 2-18-05 Existing System Inspection by: date

HEALTH DEPT. COPY: WHITE OWNER COPY (FINAL): YELLOW OWNER COPY (INITIAL): PINK