IREDELL COUNTY HEALTH DEPARTMENT

STATESVILLE 704-878-5305 MOORESVILLE 704-664-5281

IMPROVEMENT PERMIT / AUTHORIZATION TO CONSTRUCT / OPERATION PERMIT / EXISTING SYSTEM INSPECTION

PERMIT# 1164498 PIN# 4727-71-3635 DATE 11-04-03

OWNER OR CONTRACTOR KEVIN HOPE PHONE: Business 704-902-4982 Home

ADDRESS 393 RIVER RUN ROAD, STATESVILLE NC 28625

LOCATION NC 115 N, TL MALLORY LANE, 3RD LOT ON RIGHT

SUBDIVISION RED CHIMNEY MEADOWS BLOCK / SECTION 1 LOT 11 LOT AREA 0.5969 ACRE SITE CLASS. PS DESIGN FLOW 360 L.T.A.R. 0.25 GPD/FT2

Septic Tank: 1000 Gallons; STB 1012 Date 7-23-04

Pump Tank: ____ Gallons; PT ____ Date ____

Pump Make: ____ Model ____ Serial No. ____

Nitrification Field: No Fields 1 Square Feet EQ. TO 1440 Linear Feet 360

No Lines FOUR Trench Width 36" Max Trench Bottom Depth 36" Gravel Depth N/A

☑ New System ☐ Repair System Type: I, II, III, IV, V, VI

System Description: 25% REDUCTION, GRAVITY

Repair System Description: 50% REDUCTION, LOW PRESSURE

Maintenance Agreement Required: ☐ Yes ☑ No

☑ House/Mod. Home No. Bedrooms 3

☐ Mobile Home No. Bathrooms 2

☐ Business No. Employees ____

☐ Other ____

☐ Slab ☑ Crawl Space ☐ Basement w/plumbing ☐ Basement wo/plumbing


Water Supply: ☐ Individual ☑ Public ☐ Community

Comments/Conditions: ① REMOVE EXISTING FIELD TERRACE.
② INSTALL 25% REDUCTION SYSTEM AS SHOWN.

Comments/Conditions: "TUFF-TITE" FILTER & 6" RISER ON TANK
USED "INFILTRATOR" CHAMBERS

SCALE: 1" = 40'

INITIAL SITE SKETCH

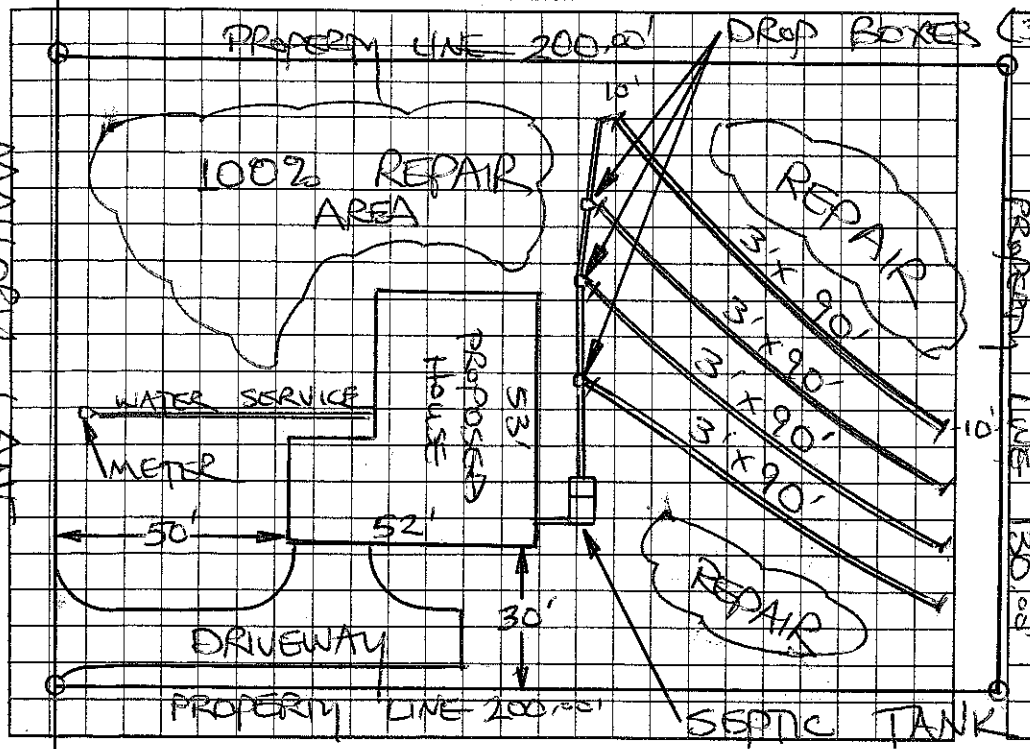

AS BUILT SKETCH

* SYSTEM INSTALLED AS SHOWN IN INITIAL SITE SKETCH

Permit can be suspended or revoked if any false information is supplied toward securing the permit/any unauthorized changes are made to the site/any unauthorized changes are made in the installation of the system. Improvement Permit with plat valid without expiration. Improvement Permit with site plan valid for sixty months. Authorization to Construct is valid for a period equal to that of Improvement Permit – not to exceed sixty months.

Signed: Kevin Hope date 11-4-03

Improvement Permit by: STEVE HEDRICK date 11-04-03

Authorization to Construct by: STEVE HEDRICK date 11-04-03

Installed by: PIEDMONT BACKHOE

Operation Permit by: [signature] LPS, LSS date 2-8-05

Existing System Inspection by: ____ date ____

HEALTH DEPT. COPY: WHITE OWNER COPY (FINAL): YELLOW OWNER COPY (INITIAL): PINK