IREDELL COUNTY HEALTH DEPARTMENT

STATESVILLE 704-878-5305 MOORESVILLE 704-664-5281

IMPROVEMENT PERMIT / AUTHORIZATION TO CONSTRUCT / OPERATION PERMIT / EXISTING SYSTEM INSPECTION

PERMIT # 1657756 PIN # 4727-71-6460 DATE APRIL 6, 2011

OWNER or APPLICANT HENDRICKS BUILDERS PHONE: Business 704-902-3286 Home: 704-872-5295

OWNER or APPLICANT ADDRESS 346 NEW STERLING ROAD, STONY POINT, NC 28678

LOCATION / DIRECTIONS NC 115 NORTH, TL MALLORY LANE, FIRST LOT ON LEFT

SUBDIVISION RED CHIMNEY MEADOWS BLOCK / SECTION LOT # 1 LOT AREA 0.69 AC DESIGN FLOW 360 L.T.A.R. 0.30 gpd/ft²

Septic Tank 1000 Gallons: STB 1000 Date 1-26-12

Pump Tank Gallons: P T Date

Pump Make Model Serial #

Nitrification Field No Fields 1 No Lines 4 Linear Feet 300

Trench Width 36" Max. Trench Bottom Depth 36" Gravel Depth N/A

☑ New System ☐ Repair ☐ Expansion System Type I II III IV V VI

System Description: 25% REDUCTION GRAVITY

Repair System Description: SHALLOW 25% REDUCTION

Maintenance Agreement Required ☐ YES ☑ NO


☑ GRAVITY ☐ PRESSURE

☑ Residence No. Bedrooms 3 ☐ Business No. Persons ☐ Other No. Employees ☐ Slab ☑ Crawl Space ☐ Basement w/plumbing ☐ Basement w/o plumbing

Water Supply: ☐ Private ☑ Public ☐ Community


Comments / Conditions: INSTALL 25% REDUCTION SYSTEM ON CONTOUR AS SHOWN USING SERIAL DISTRIBUTION

INITIAL SITE SKETCH

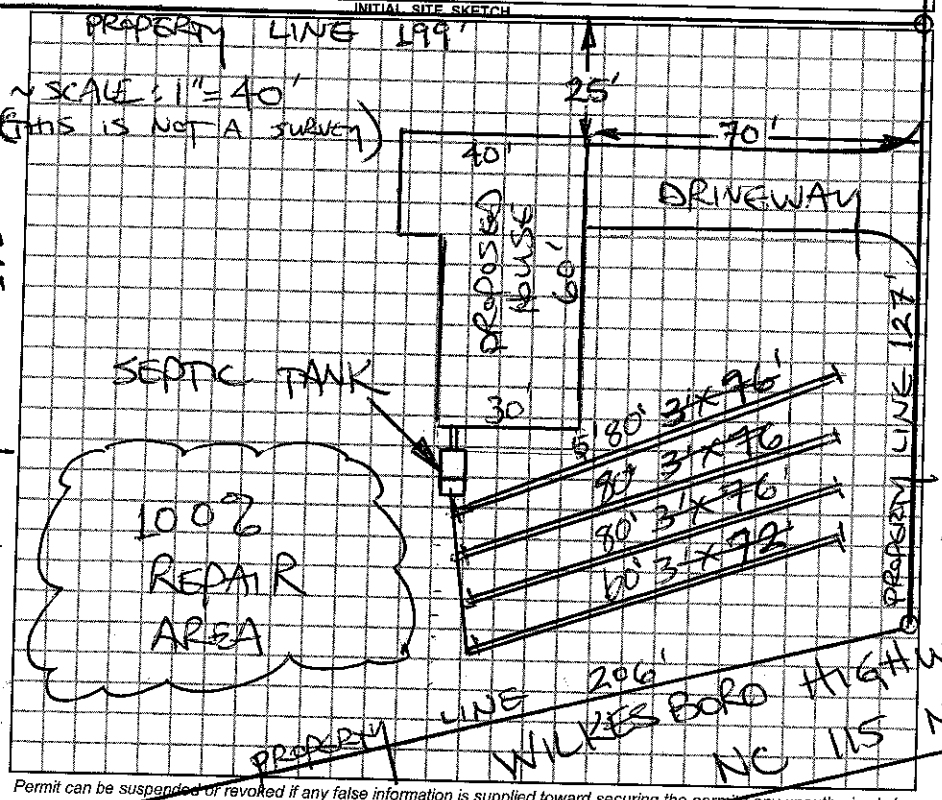

Comments / Conditions: Quick4 Chambers installed
Red Polylok filter installed
2" PVC septic tank marker installed

AS BUILT SKETCH

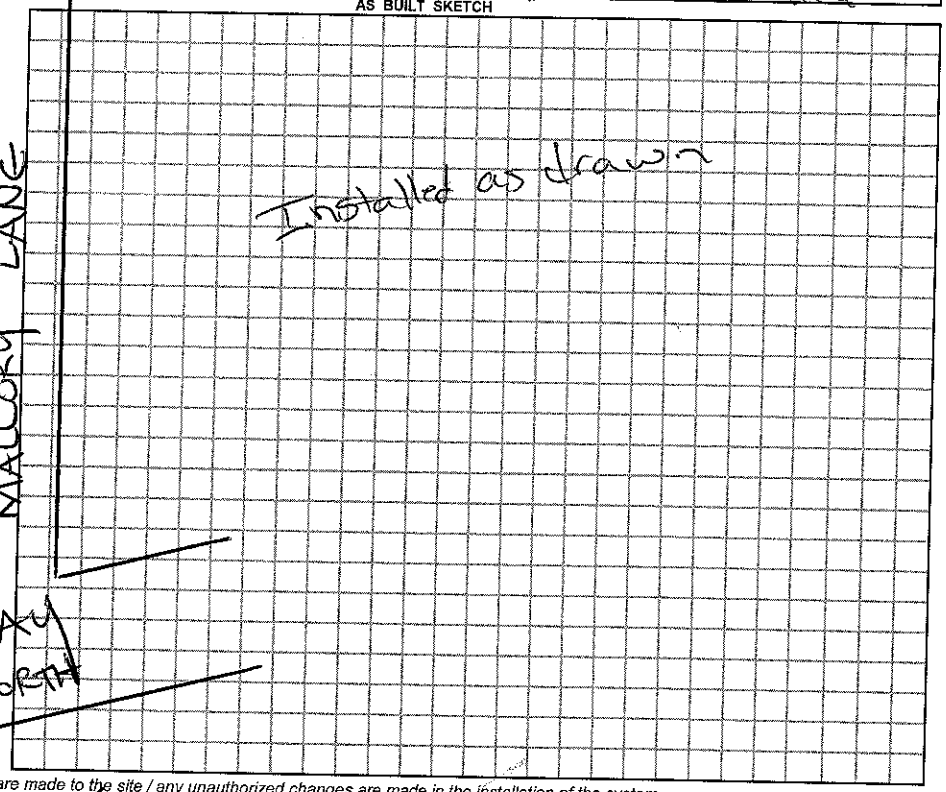

Permit can be suspended or revoked if any false information is supplied toward securing the permit / any unauthorized changes are made to the site / any unauthorized changes are made in the installation of the system.

☐ *IMPROVEMENT PERMIT w / plat valid without expiration.* ☑ *IMPROVEMENT PERMIT w / site plan valid for 60 mos.* ☑ *AUTHORIZATION TO CONSTRUCT valid for period equal to IMPROVEMENT PERMIT-not to exceed 60 mo.*

Owner / Applicant Signature: Mark Hendrick Date 4-6-11

Improvement Permit by: STEVE HEDRICK Date 4/6/2011

Authorization to Construct by: STEVE HEDRICK Date 4/6/2011

YOU SHOULD CONTACT A LOCATOR SERVICE PRIOR TO ANY EXCAVATION.

Installed by: Groundbreakers

Operation Permit by: Justin Hendrix Date: 10-3-12

Existing System Inspected by: Date:

WHITE COPY Environmental Health YELLOW COPY (Final) Owner / Applicant PINK COPY (Initial) Owner / Applicant