IREDELL COUNTY HEALTH DEPARTMENT

STATESVILLE 704-878-5305 MOORESVILLE 704-664-5281

IMPROVEMENT PERMIT / AUTHORIZATION TO CONSTRUCT / OPERATION PERMIT / EXISTING SYSTEM INSPECTION

PERMIT# 095629 PIN# 4727 17 8949 DATE 4/25/01

OWNER OR CONTRACTOR JENKINS AND WILLIAMS PHONE: Business (704) 872- Home

ADDRESS P.O. BOX 5877, STATESVILLE, NC 28677

LOCATION 115 N ON (R) B/F RED CHIMNEY RD.

SUBDIVISION IRMA ACRES BLOCK / SECTION I LOT 1 LOT AREA .9 AC. SITE CLASS PS DESIGN FLOW 360 GPD L.T.A.R. .30

Septic Tank: 1000 Gallons: STB 1012 Date 9-12-01
Pump Tank: Gallons: PT Date
Pump Make: Model Serial No.
Nitrification Field: No Fields 1 Square Feet 1028 Linear Feet 300'
No Lines 3 Trench Width 3' Max Trench Bottom Depth 36" Gravel Depth N/A

☑ New System ☐ Repair System Type: I, II, (III), IV, V, VI
System Description: 25% REDUCTION
Repair System Description: 50% REDUCTION
Maintenance Agreement Required: ☐ Yes ☑ No
☐ Slab ☐ Crawl Space ☑ Basement w/plumbing ☐ Basement wo/plumbing


☑ House/Mod. Home No. Bedrooms 3
☐ Mobile Home No. Bathrooms 2
☐ Business No. Employees
☐ Other

Water Supply: ☐ Individual ☑ Public ☐ Community

Comments/Conditions: ① INSTALL DRAINLINES UNIFORM AND ON CONTOUR
② NO CUTTING OR FILLING OVER DRAINFIELD/REPAIR AREAS
③ KEEP ALL DRAINS AWAY FROM DRAINFIELD/REPAIR AREAS
④ MAINTAIN SETBACKS

Comments/Conditions: SEPTIC TANK WITH MARKER INSTALLED USING "POLYLOK" FILTER

INITIAL SITE SKETCH * NOT TO SCALE

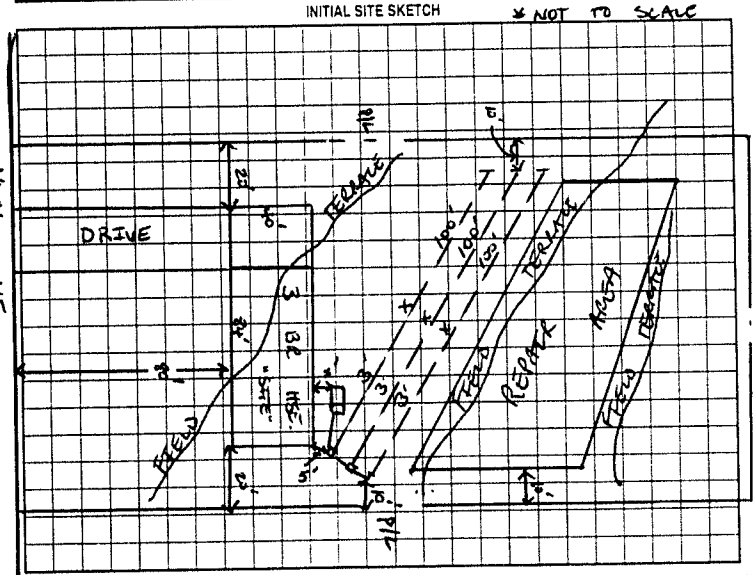

AS BUILT SKETCH

SYSTEM INSTALLED ACCORDING TO INITAL SITE SKETCH USING 48 CHAMBERS ("INFILTRATOR")

Permit can be suspended or revoked if any false information is supplied toward securing the permit/any unauthorized changes are made to the site/any unauthorized changes are made in the installation of the system. Improvement Permit with plan valid without expiration. Improvement Permit with site plan valid for sixty months. Authorization to Construct is valid for a period equal to that of Improvement Permit – not to exceed sixty months.

Signed: [signature] date 3/21/01 Installed by: TOMMY FRYE

Improvement Permit by: [signature] date 4/25/01 Operation Permit by: STEVE HERRICK date 11-15-01

Authorization to Construct by: [signature] date 4/25/01 Existing System Inspection by: date

HEALTH DEPT. COPY WHITE OWNER COPY (FINAL) YELLOW OWNER COPY (INITIAL) PINK