CJ

IREDELL COUNTY HEALTH DEPARTMENT

CI

STATESVILLE 704-878-5305 MOORESVILLE 704-664-5281

IMPROVEMENT PERMIT / AUTHORIZATION TO CONSTRUCT / OPERATION PERMIT / EXISTING SYSTEM INSPECTION

PERMIT# 105538 PIN# 4727-72-9440 DATE Sept 12, 02

OWNER OR CONTRACTOR Foy-White Partnership PHONE: Business 872-0072 Home

ADDRESS P.O. Box 5671 Statesville, N.C. 28687

LOCATION 115 N. TR Red Chimney on Right before jct w/ Foy Rd

SUBDIVISION Irma Acres/North Carolina BLOCK / SECTION 1 LOT 6 LOT AREA ~25,196 ft² SITE CLASS. PS DESIGN FLOW 360 gpd L.T.A.R. .03

Septic Tank: 1000 Gallons; STB 1007 Date 12-17-03

Pump Tank: Gallons; PT Date

Pump Make: Model Serial No.

Nitrification Field: No Fields 2 Square Feet 1200 Linear Feet 400

No Lines 2+2 Trench Width 36" 9'oc Max Trench Bottom Depth 36" Gravel Depth 12"

☑ New System ☐ Repair System Type: I, II, III, IV, V, VI

System Description: Gravity Conventional

Repair System Description: Gravity/pumped 25% Reduction

Maintenance Agreement Required: ☐ Yes ☑ No

☑ House/Mod. Home No. Bedrooms 3

☐ Mobile Home No. Bathrooms 2

☐ Business No. Employees

☐ Other

☐ Slab ☑ Crawl Space ☐ Basement w/plumbing ☐ Basement wo/plumbing


Water Supply: ☐ Individual ☑ Public ☐ Community

Comments:/Conditions: Remove ("shave off") old Burn -

Comments:/Conditions: Tuff Tite Filter + ST marker Installed - drop boxes used

1"=50'

INITIAL SITE SKETCH

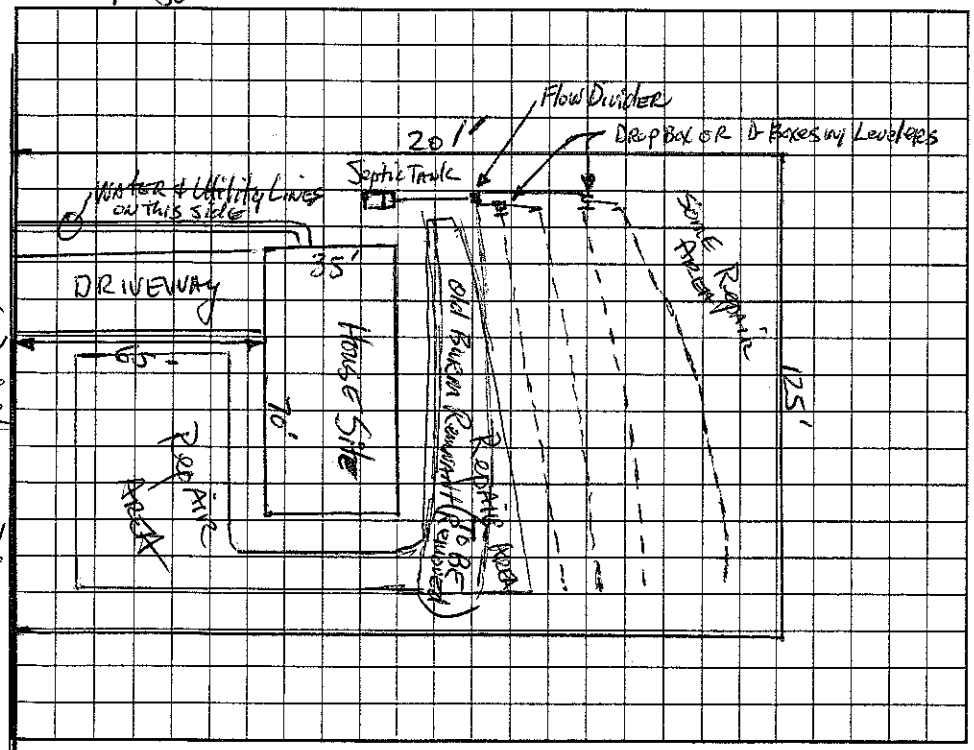

AS BUILT SKETCH

Installed as shown per Initial Site Sketch

RW Red Chimney Rd.

Permit can be suspended or revoked if any false information is supplied toward securing the permit/any unauthorized changes are made to the site/any unauthorized changes are made in the installation of the system. Improvement Permit with plat valid without expiration/Improvement Permit with site plan valid for sixty months. Authorization to Construct is valid for a period equal to that of Improvement Permit – not to exceed sixty months.

Signed: date 11/7/02 Installed by: CJ's Backhoe / Taylorsville, N.C.

Improvement Permit by: date 9-12-02 Operation Permit by: William C. Johnson date 4/6/04

Authorization to Construct by: William C. Johnson date 1-16-03 Existing System Inspection by: date

HEALTH DEPT. COPY: WHITE OWNER COPY (FINAL): YELLOW OWNER COPY (INITIAL): PINK