IREDELL COUNTY HEALTH DEPARTMENT

STATESVILLE 704-878-5305 MOORESVILLE 704-664-5281

IMPROVEMENT PERMIT / AUTHORIZATION TO CONSTRUCT / OPERATION PERMIT / EXISTING SYSTEM INSPECTION

PERMIT# 105494 PIN# 4727-86-2998 DATE 1-4-06

OWNER OR CONTRACTOR Faye White Partnership PHONE: Business Home

ADDRESS PO Box 5171 Statesville NC 28687

LOCATION 115 N to Red Chimney to Fay Lane on Right Near End

SUBDIVISION North Crossing BLOCK / SECTION 2 LOT 23 LOT AREA 1.63 SITE CLASS R3 DESIGN FLOW 360 L.T.A.R. .3

Septic Tank: 1000 Gallons; STB 525 Date 3-30-06
Pump Tank: Gallons; PT Date
Pump Make: Model Serial No.
Nitrification Field: No Fields Square Feet 1200 Linear Feet 300
No Lines 4 Trench Width 36" Max Trench Bottom Depth 24" Gravel Depth

☑ New System ☐ Repair System Type: I II III IV V VI
System Description: 25% Graver
Repair System Description: 25% Gravel-Pump from
Maintenance Agreement Required: ☐ Yes ☑ No

☑ House/Mod. Home No. Bedrooms 3
☐ Mobile Home No. Bathrooms
☐ Business No. Employees
☐ Other


☐ Slab ☑ Crawl Space ☐ Basement w/plumbing ☐ Basement wo/plumbing

Water Supply: ☐ Individual ☑ Public ☐ Community


Comments:/Conditions:

Comments:/Conditions:
Blue Tuff Stuff filter
Septic tank make

INITIAL SITE SKETCH

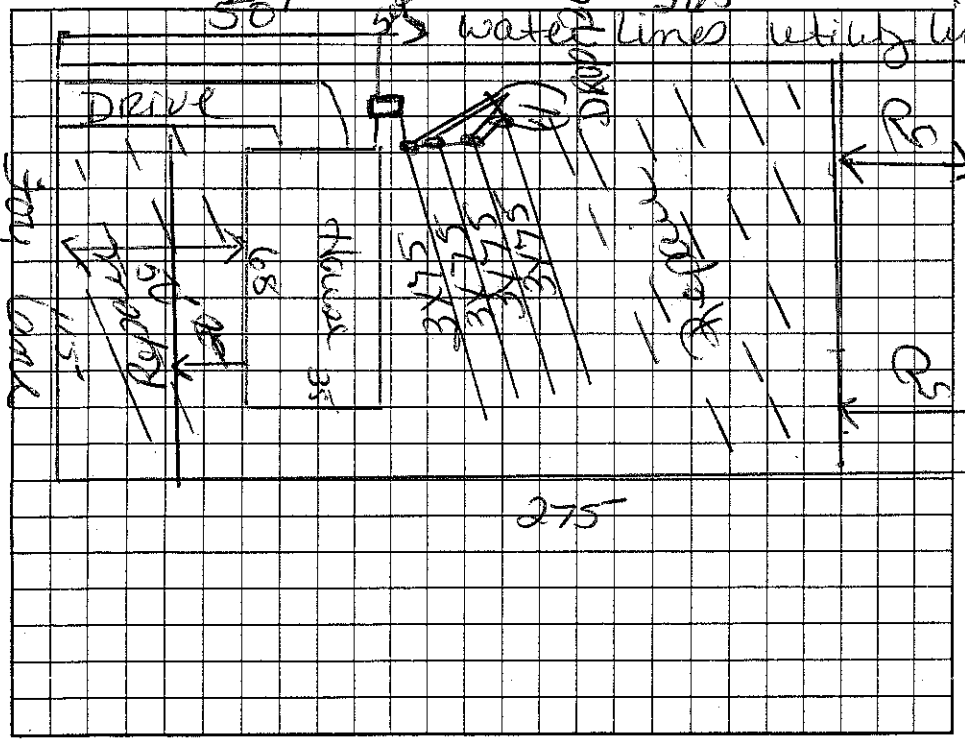

AS BUILT SKETCH

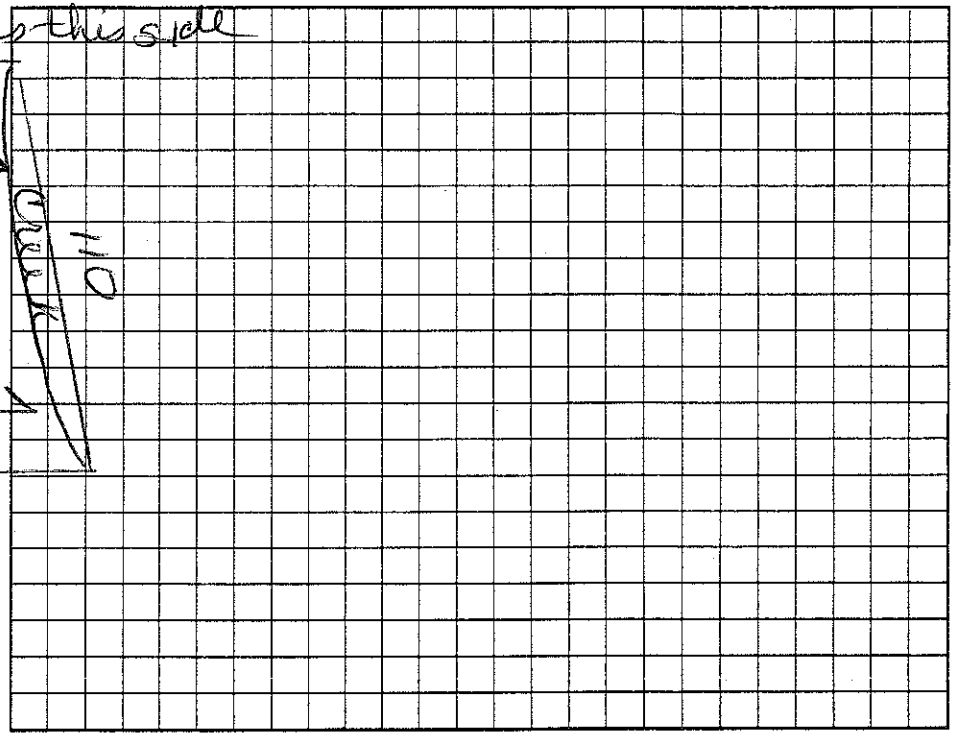

Permit can be suspended or revoked if any false information is supplied toward securing the permit/any unauthorized changes are made to the site/any unauthorized changes are made in the installation of the system. Improvement Permit with plat valid without expiration. Improvement Permit with site plan valid for sixty months. Authorization to Construct is valid for a period equal to that of Improvement Permit – not to exceed sixty months.

Signed: John W. Wilburn Jr. date 1-9-06 Installed by: Cadillac

Improvement Permit by: Kelli Cook date 1-4-06 Operation Permit by: Kelli Cook date 5-11-06

Authorization to Construct by: Kelli Cook date 1-4-06 Existing System Inspection by: date

HEALTH DEPT. COPY: WHITE OWNER COPY (FINAL): YELLOW OWNER COPY (INITIAL): PINK