IREDELL COUNTY HEALTH DEPARTMENT - *ENVIRONMENTAL HEALTH* ☑ STATESVILLE OFFICE 704-878-5305 ☐ MOORESVILLE OFFICE 704-664-5281

IMPROVEMENT PERMIT / AUTHORIZATION TO CONSTRUCT / OPERATION PERMIT / EXISTING SYSTEM INSPECTION

PERMIT # 1669 37 PIN # 4727802998 DATE 6-27-11

OWNER Christopher Phelan APPLICANT: PHONE: Home/Cell # 704-325-9732 Business #

SITE ADDRESS 176 Foy Lane OWNER / APPLICANT ADDRESS 176 Foy Lane

SITE DIRECTIONS 115 North, Red Chimney (R), Foy (R) property on (R)

SUBDIVISION North Crossing BLOCK / SECTION LOT # 23 LOT AREA .630 DESIGN FLOW 360 L.T.A.R. .3

Septic Tank Ex Gallons: STB Ex Date Ex
Pump Tank Gallons: P T Date
Pump Make Model Serial #
No. Nitrification Fields: Ex No. Lines Ex Linear Feet Ex
Trench Width Ex Max. Trench Bottom Depth Ex

☐ New System ☐ Repair ☐ Expansion System Type I II (III) IV V VI
System Description: Existing (25% Reduction)
Repair System Description:
Maintenance Agreement Required ☐ YES ☐ NO
☑ GRAVITY ☐ PRESSURE Gravel Depth


☒ Residence No. Bedrooms 3
☐ Business No. Persons
☐ Other No. Employees
☐ Slab ☒ Crawl Space
☐ Basement w/plumbing ☐ Basement w/o plumbing

Water Supply
☐ Private
☒ Public
☐ Community


Comments / Conditions

See attached permit

INITIAL SITE SKETCH

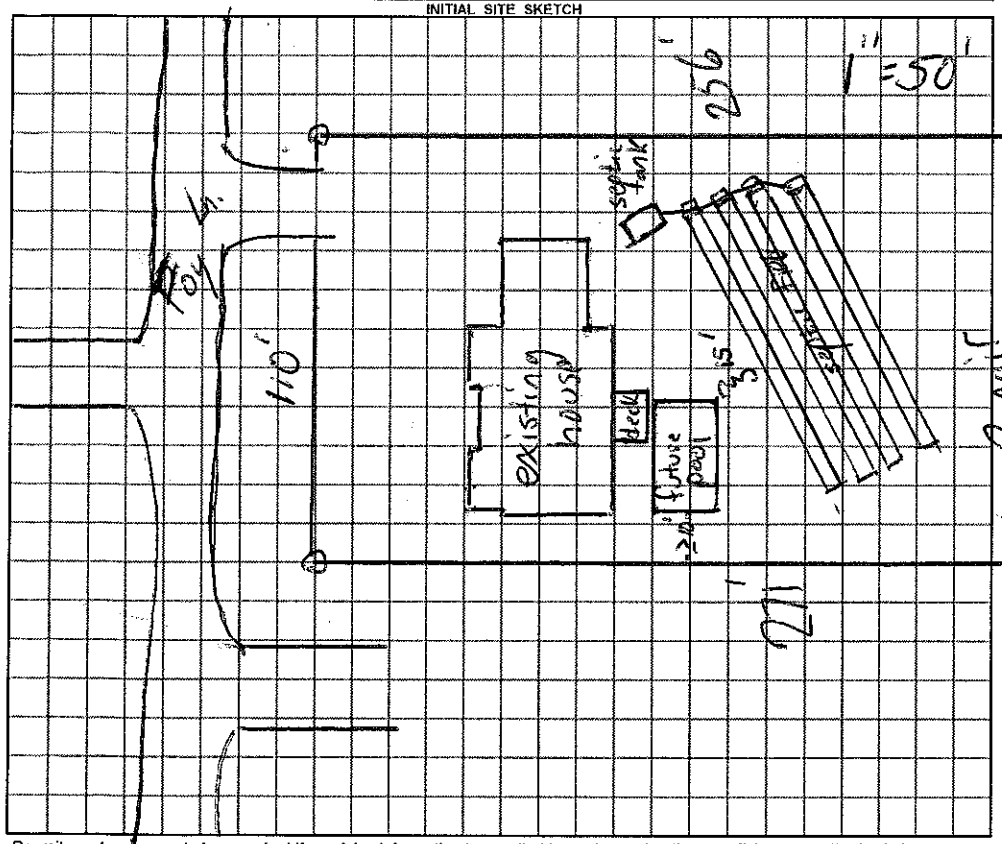

AS BUILT SKETCH

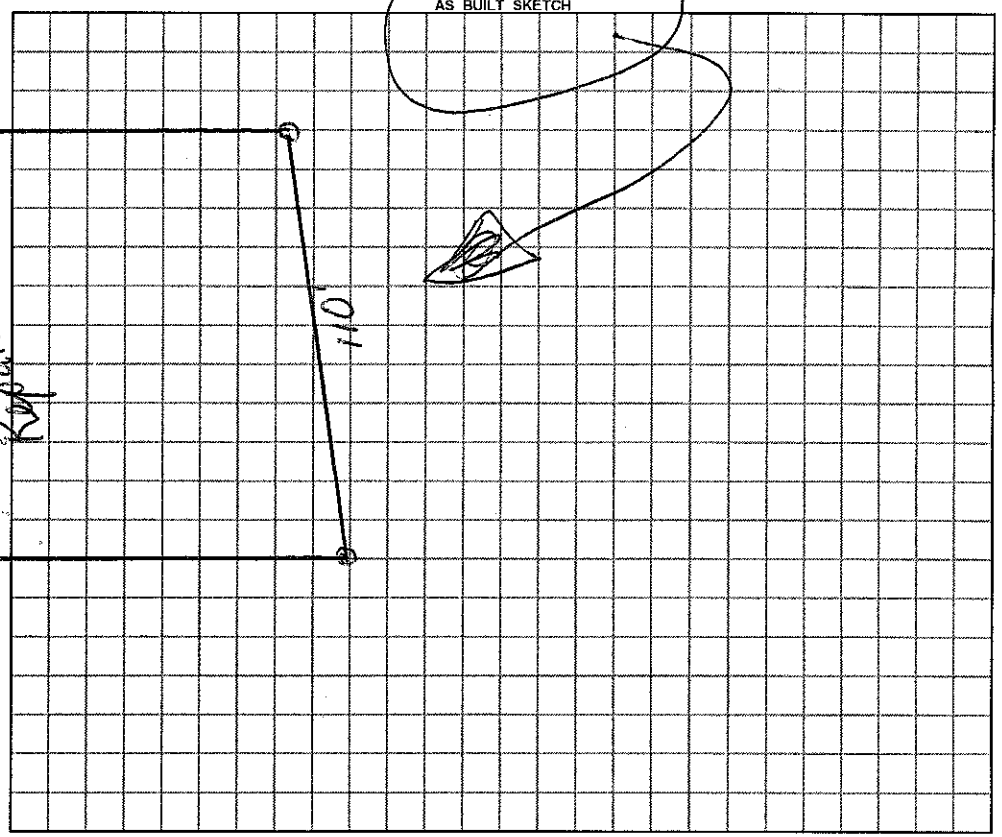

Permit can be suspended or revoked if any false information is supplied toward securing the permit / any unauthorized changes are made to the site / any unauthorized changes are made in the installation of the system.

☐ ***IMPROVEMENT PERMIT*** with plat valid without expiration. ☐ ***IMPROVEMENT PERMIT*** with ~~plat valid without expiration.~~ site plan valid 60 mo. ☐ ***AUTHORIZATION TO CONSTRUCT*** valid for period equal to IMPROVEMENT PERMIT--not to exceed 60 mo.

Owner / Applicant Signature: Date Installed by:

IMPROVEMENT PERMIT by: REHS Date OPERATION PERMIT by: REHS Date

AUTHORIZATION TO CONSTRUCT by: REHS Date Existing System Inspected by: REHS Date 6-27-11

YOU SHOULD CONTACT A LOCATOR SERVICE PRIOR TO ANY EXCAVATION

White Copy – Environmental Health YELLOW COPY (Final) Owner / Applicant PINK COPY (Initial) Owner / Applicant