IREDELL COUNTY HEALTH DEPARTMENT

STATESVILLE 704-878-5305 MOORESVILLE 704-664-5281

IMPROVEMENT PERMIT / AUTHORIZATION TO CONSTRUCT / OPERATION PERMIT / EXISTING SYSTEM INSPECTION

PERMIT# 144526 PIN# 4628803807 DATE 5-27-08

OWNER OR APPLICANT Custom Homes by Lisa PHONE: Business 704-876-4967 Home

ADDRESS 194 Cross Country Rd Statesville NC 28625

LOCATION 115 N to Red Shamsley to Gray Cullowee

SUBDIVISION North Cassorg BLOCK / SECTION 2 LOT 22 LOT AREA 1.630 SITE CLASS B DESIGN FLOW 360 L.T.A.R. .125

Septic Tank: 1000 Gallons; STB 760 Date 1-25-08

Pump Tank: Gallons; PT Date

Pump Make: Model Serial No.

Nitrification Field: No Fields Square Feet 440 Linear Feet 240

No Lines 5 Trench Width 24" Max Trench Bottom Depth 36

☑ New System ☐ Repair ☐ Expansion System Type: I II III IV V VI

System Description: 50% Gravity

Repair System Description: 50% Low Pressure

Maintenance Agreement Required: ☐ Yes ☑ No

Gravel Depth 11" ☑ Gravity ☐ Pressure

☑ House/Mod. Home ☐ Mobile Home ☐ Business ☐ Other

No. Bedrooms 3 No. Persons No. Employees


Water Supply: ☐ Individual ☑ Public ☐ Community

☐ Slab ☐ Crawl Space ☐ Basement w/plumbing ☐ Basement wo/plumbing

Comments:/Conditions:

56 Lineal - 11 per line
40 Tons of Stone


INITIAL SITE SKETCH

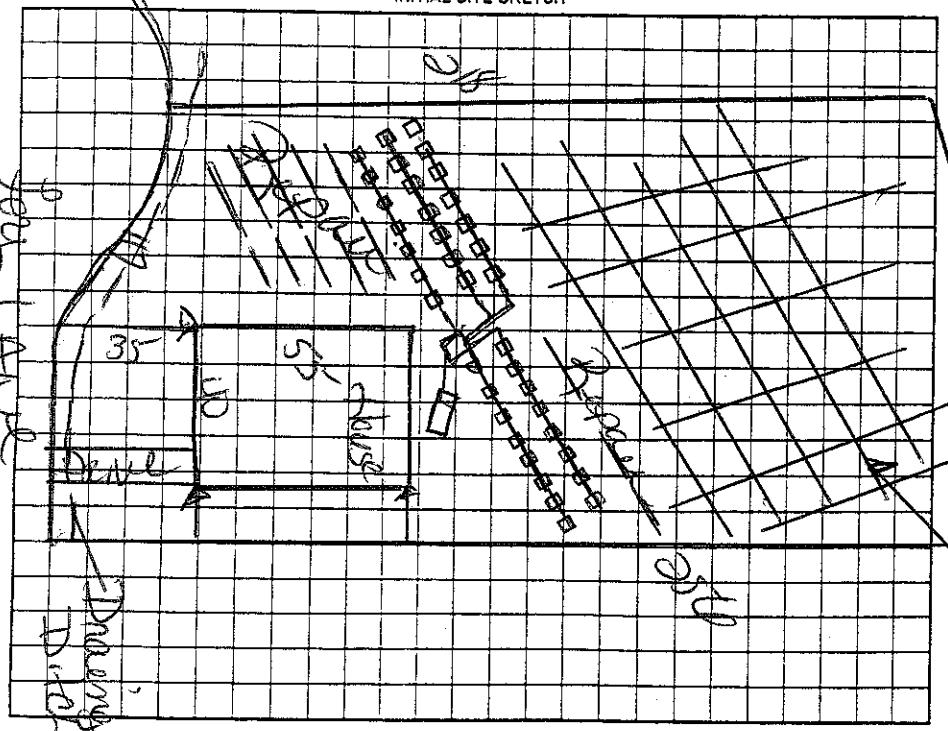

Comments:/Conditions:

Use Effluent Splitter
Install on Contour
Maintain all setbacks

AS BUILT SKETCH

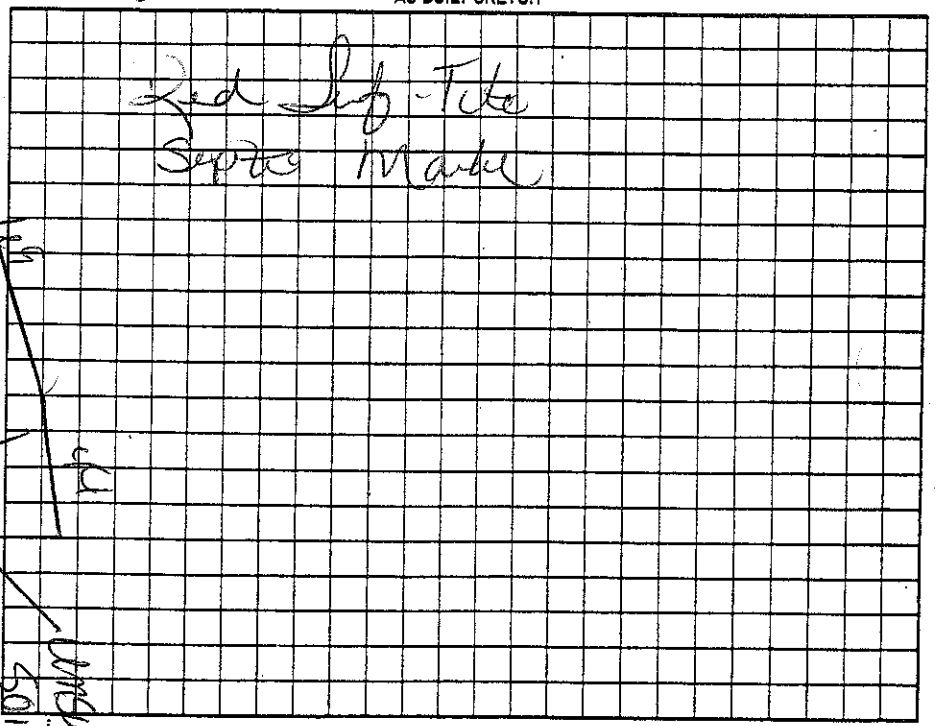

Permit can be suspended or revoked if any false information is supplied toward securing the permit/any unauthorized changes are made to the site/any unauthorized changes are made in the installation of the system. Improvement Permit with plat valid without expiration ☐ Improvement Permit with site plan valid for sixty months ☐ Authorization to Construct is valid for a period equal to that of Improvement Permit – not to exceed sixty months.

Signed: Lisa Williams date 6/12/08 Installed by: Madison Grading

Improvement Permit by: Ruth Cox date 5-27-08 Operation Permit by: Ruth Cox date 7-6-08

Authorization to Construct by: Ruth Cox date 5-27-08 Existing System Inspection by: date

HEALTH DEPT. COPY: WHITE OWNER COPY (FINAL): YELLOW OWNER COPY (INITIAL): PINK