IREDELL COUNTY HEALTH DEPARTMENT

Statesville Phone TR 3-7271 — Mooresville Phone NO 3-1271

PERMIT TO INSTALL SEPTIC TANK

Permit No. 174 — Permit Date 10-2 1972

Owner Blor. George Mahaffey — Address Statesville, NC

Installed By Lackey Bro. — Address Stony Point, NC


Location of Property 115 N- cross 4th Creek, 2nd House on Rt.

Tank		Capacity		Length of Lines		Fixtures	
Block	( )	1000	( )	225'	( )	No. of Baths	(3)
Precast	(✓)	1250	(✓)	250'	( )	Dishwasher	( )
		1500	( )	Other 255		Garbage Grdr.	( )
		Other				Other	

NOTIFY HEALTH DEPARTMENT AT LEAST EIGHT HOURS BEFORE TANK IS TO BE INSPECTED.

Final Inspection 10-2 1972 — Approved (✓) Disapproved ( )

Remarks

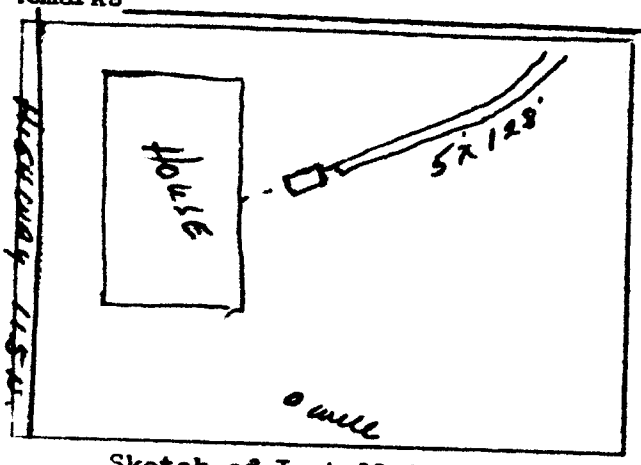

Sketch of Installation

Glenn Todd Jr.
Sanitarian