IREDELL COUNTY HEALTH DEPARTMENT

STATESVILLE 704-878-5305 CI MOORESVILLE 704-664-5281

IMPROVEMENT PERMIT / AUTHORIZATION TO CONSTRUCT / OPERATION PERMIT / EXISTING SYSTEM INSPECTION

(1)

PERMIT# 105440 PIN# 4727-81-1965 704-924-4916 DATE 9-3-05

OWNER OR CONTRACTOR Custom Homes by LISA, INC PHONE: Business 704-902-9182 Home 704-872-6165

ADDRESS 517 STENCIN CT STATESVILLE NC 28677

LOCATION NC 115 N TR RED CHIMNEY RD TR FOY LANE LOT ON RIGHT

SUBDIVISION NORTH CROSSING BLOCK / SECTION 1 LOT 1 LOT AREA 0.433 ACRE SITE CLASS. PS DESIGN FLOW 360 L.T.A.R. 0.30 GPD/FT2

Septic Tank: 1000 Gallons; STB 760 Date 1-6-08

Pump Tank: 1000 Gallons; PT 363 Date 1-6-08

Pump Make: Zoeller Model N-151B Serial No.

Nitrification Field: No Fields 1 Square Feet 200 Linear Feet 200

No Lines FOUR Trench Width 24" Max Trench Bottom Depth 36" Gravel Depth SAND 24"

☑ New System ☐ Repair System Type: I, II, III, IV, V, VI (3)

System Description: 50% REDUCTION, PUMP

Repair System Description: 50% REDUCTION, LOW PRESSURE

Maintenance Agreement Required: ☐ Yes ☑ No

☑ House/Mod. Home ☐ Mobile Home ☐ Business ☐ Other


No. Bedrooms 3 No. Bathrooms ___ No. Employees ___

Water Supply: ☐ Individual ☑ Public ☐ Community

Comments:/Conditions: (2) CONSTRUCT HIGH CRAWL SPACE WITH BACKFILL FOR POSITIVE DRAINAGE - NO CUTTING ALLOWED (2) INSTALL 50% REDUCTION SYSTEM ON CONTOUR USING 48 PANELS (3) SEE ATTACHED SHEETS FOR PUMP & P.M. REQUIREMENTS.

Comments:/Conditions:

INITIAL SITE SKETCH

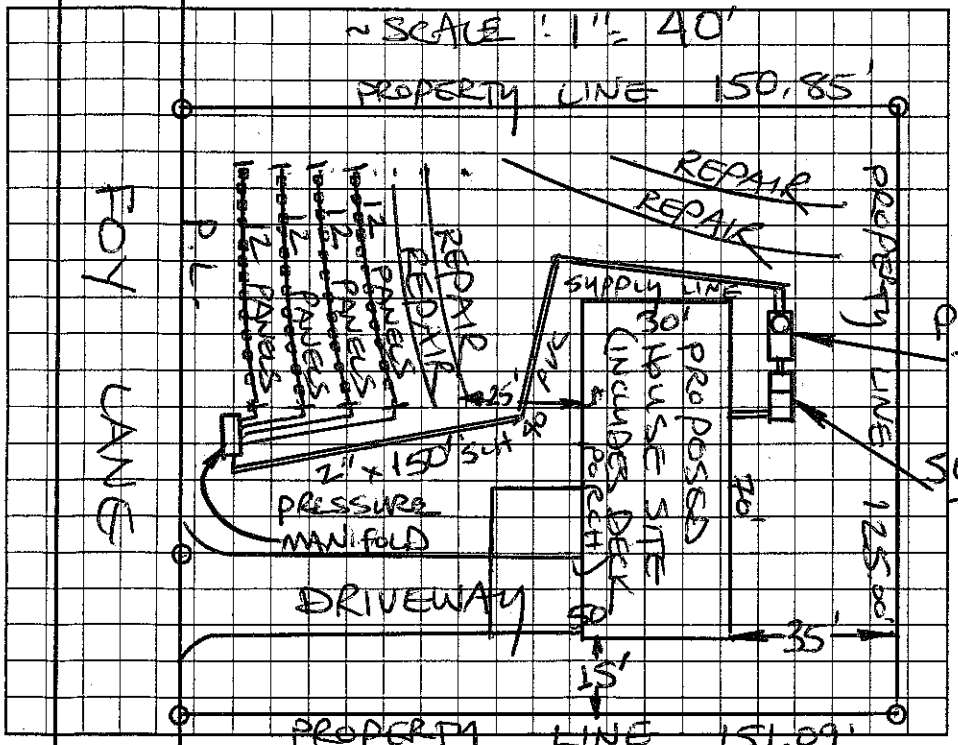

AS BUILT SKETCH

Permit can be suspended or revoked if any false information is supplied toward securing the permit/any unauthorized changes are made to the site/any unauthorized changes are made in the installation of the system. Improvement Permit with plat valid without expiration. Improvement Permit with site plan valid for sixty months. Authorization to Construct is valid for a period equal to that of Improvement Permit – not to exceed sixty months.

Signed: Lisa C. Williams date 4-4-06 Installed by: Madison Grading

Improvement Permit by: STEVE HEDRICK date 9-3-05 Operation Permit by: [signature] date 5-16-08

Authorization to Construct by: STEVE HEDRICK date 7-30-07 Existing System Inspection by: ___ date ___

HEALTH DEPT. COPY: WHITE OWNER COPY (FINAL): YELLOW OWNER COPY (INITIAL): PINK