300

THIS PERMIT REPLACES PREVIOUS ISSUED 5-4-2002

# IREDELL COUNTY HEALTH DEPARTMENT

STATESVILLE 704-878-5305 (a) MOORESVILLE 704-664-5281

## IMPROVEMENT PERMIT / AUTHORIZATION TO CONSTRUCT / OPERATION PERMIT / EXISTING SYSTEM INSPECTION

PERMIT# 105458 PIN# 4727-81-2294 DATE 9-14-2006

OWNER OR APPLICANT CUSTOM HOMES BY LISA, INC PHONE: Business 704-902-0733 Home

ADDRESS 220 CROSS COUNTRY ROAD STATESVILLE, NC 28625

LOCATION NC 115 NORTH, TR RED CHIMNEY RD, TR FOY LANE 10TH LOT ON RIGHT

SUBDIVISION NORTH CROSSING BLOCK / SECTION II LOT 26 LOT AREA 0.91 ACRE SITE CLASS. BS DESIGN FLOW 360 L.T.A.R. 0.25 GAD/SQ FT

Septic Tank: 1000 Gallons; STB 794 Date 11-22-06

Pump Tank: Gallons; PT Date

Pump Make: Model Serial No.

Nitrification Field: No Fields 1 Square Feet EQ TO 1440 Linear Feet 240

No Lines FIVE Trench Width 24" Max Trench Bottom Depth 36" SAND Depth 24"

☑ New System ☐ Repair ☐ Expansion System Type: I II III IV V VI

System Description: 50% REDUCTION, GRAVITY

Repair System Description: 50% REDUCTION, LOW PRESSURE

Maintenance Agreement Required: ☐ Yes ☑ No

☑ House/Mod. Home ☐ Mobile Home ☐ Business ☐ Other

No. Bedrooms 3 No. Persons No. Employees


Water Supply: ☐ Individual ☑ Public ☐ Community

☑ Gravity ☐ Pressure ☐ Slab ☐ Crawl Space ☐ Basement w/plumbing ☐ Basement wo/plumbing


Comments:/Conditions: INSTALL 50% REDUCTION SYSTEM ON CONTOUR AS SHOWN USING 5E PIPPS PANELS. USE ONE EFFLUENT SPLITTER (SUCH AS "ZOELLER TRU-FLO") TO ACHIEVE EQUAL DISTRIBUTION.

Comments:/Conditions: SEPTIC TANK WITH MARKER INSTALLED USING "BOWCO" FILTER

INITIAL SITE SKETCH

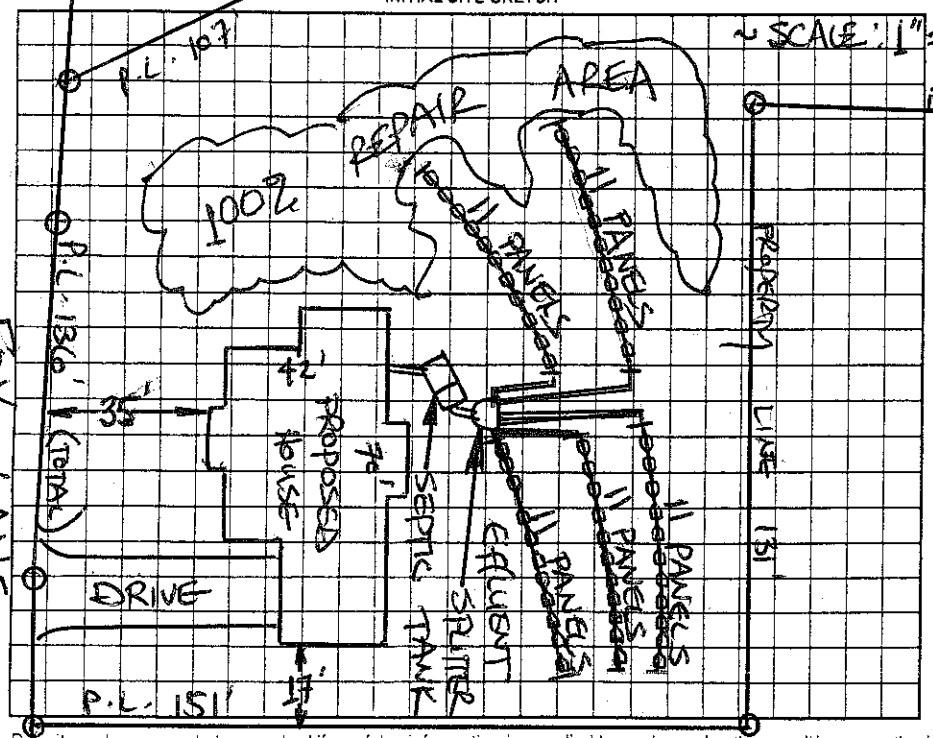


AS BUILT SKETCH

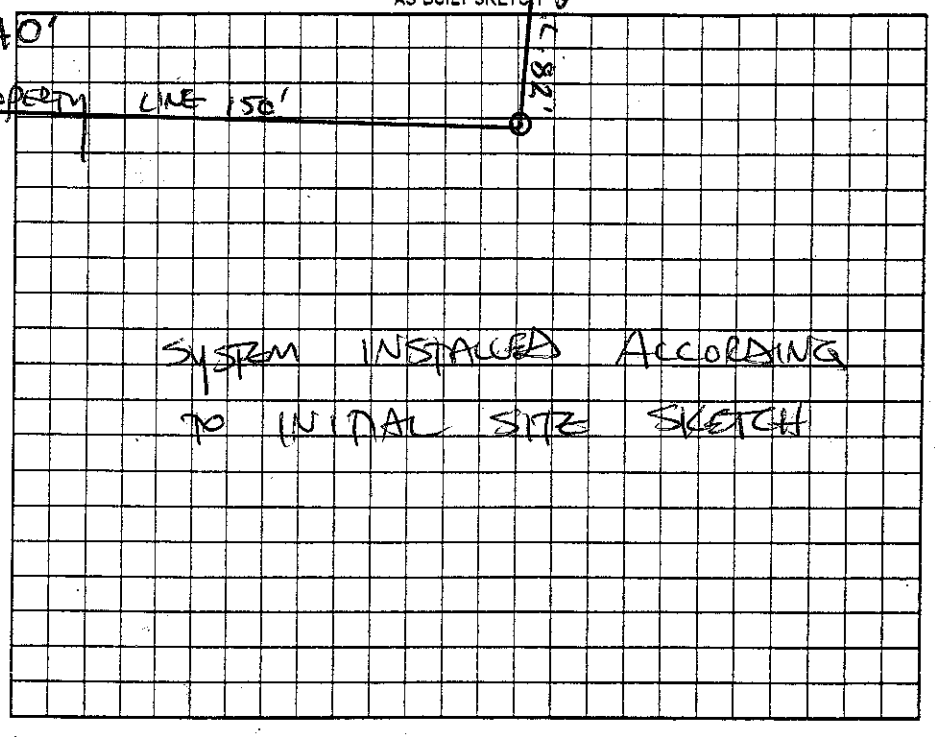


Permit can be suspended or revoked if any false information is supplied toward securing the permit/any unauthorized changes are made to the site/any unauthorized changes are made in the installation of the system. Improvement Permit with plat valid without expiration. ☐ Improvement Permit with site plan valid for sixty months ☑ Authorization to Construct is valid for a period equal to that of Improvement Permit – not to exceed sixty months.

Signed: Lisa C. Williams date 10-10-06 Installed by: KENNY MADISON

Improvement Permit by: STEVE HEDRICK date 9-14-2002 Operation Permit by: STEVE HEDRICK date 2-12-07

Authorization to Construct by: STEVE HEDRICK date 9-14-2002 Existing System Inspection by: date

HEALTH DEPT. COPY: WHITE OWNER COPY (FINAL): YELLOW OWNER COPY (INITIAL): PINK